


Map to Accompany Application for Permit to Appropriate Water

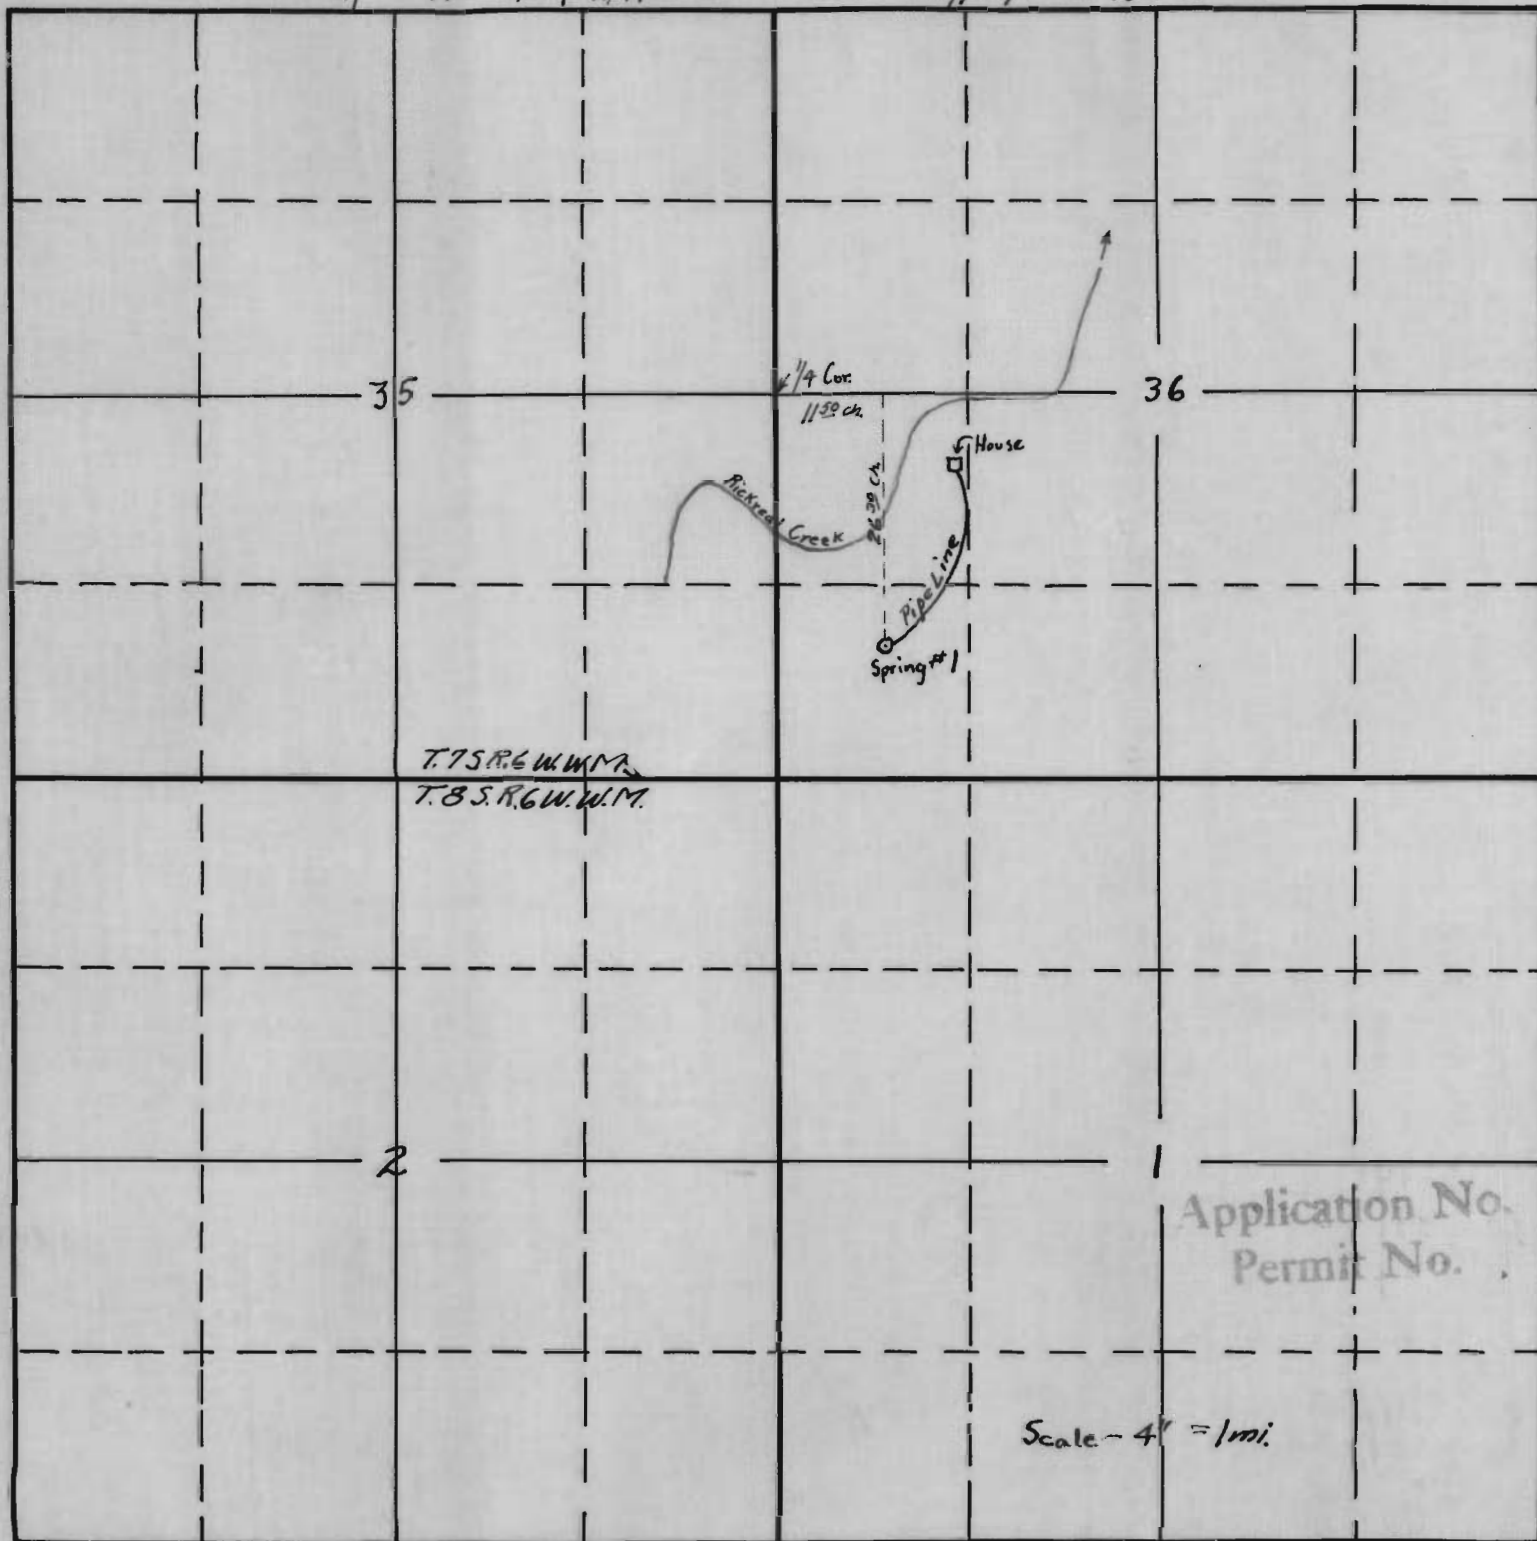

Sec. 35
36
1
2

Tp. 7+8 S

R. 6 W.W.M

Application No. 11460
Permit No. 7920

Scale - 4" = 1 mi.

MAP TO ACCOMPANY APPLICATION FOR PERMIT TO APPROPRIATE WATER

Sec. 35


36

1

2

TP. 7485.

R. 6W.W.M.

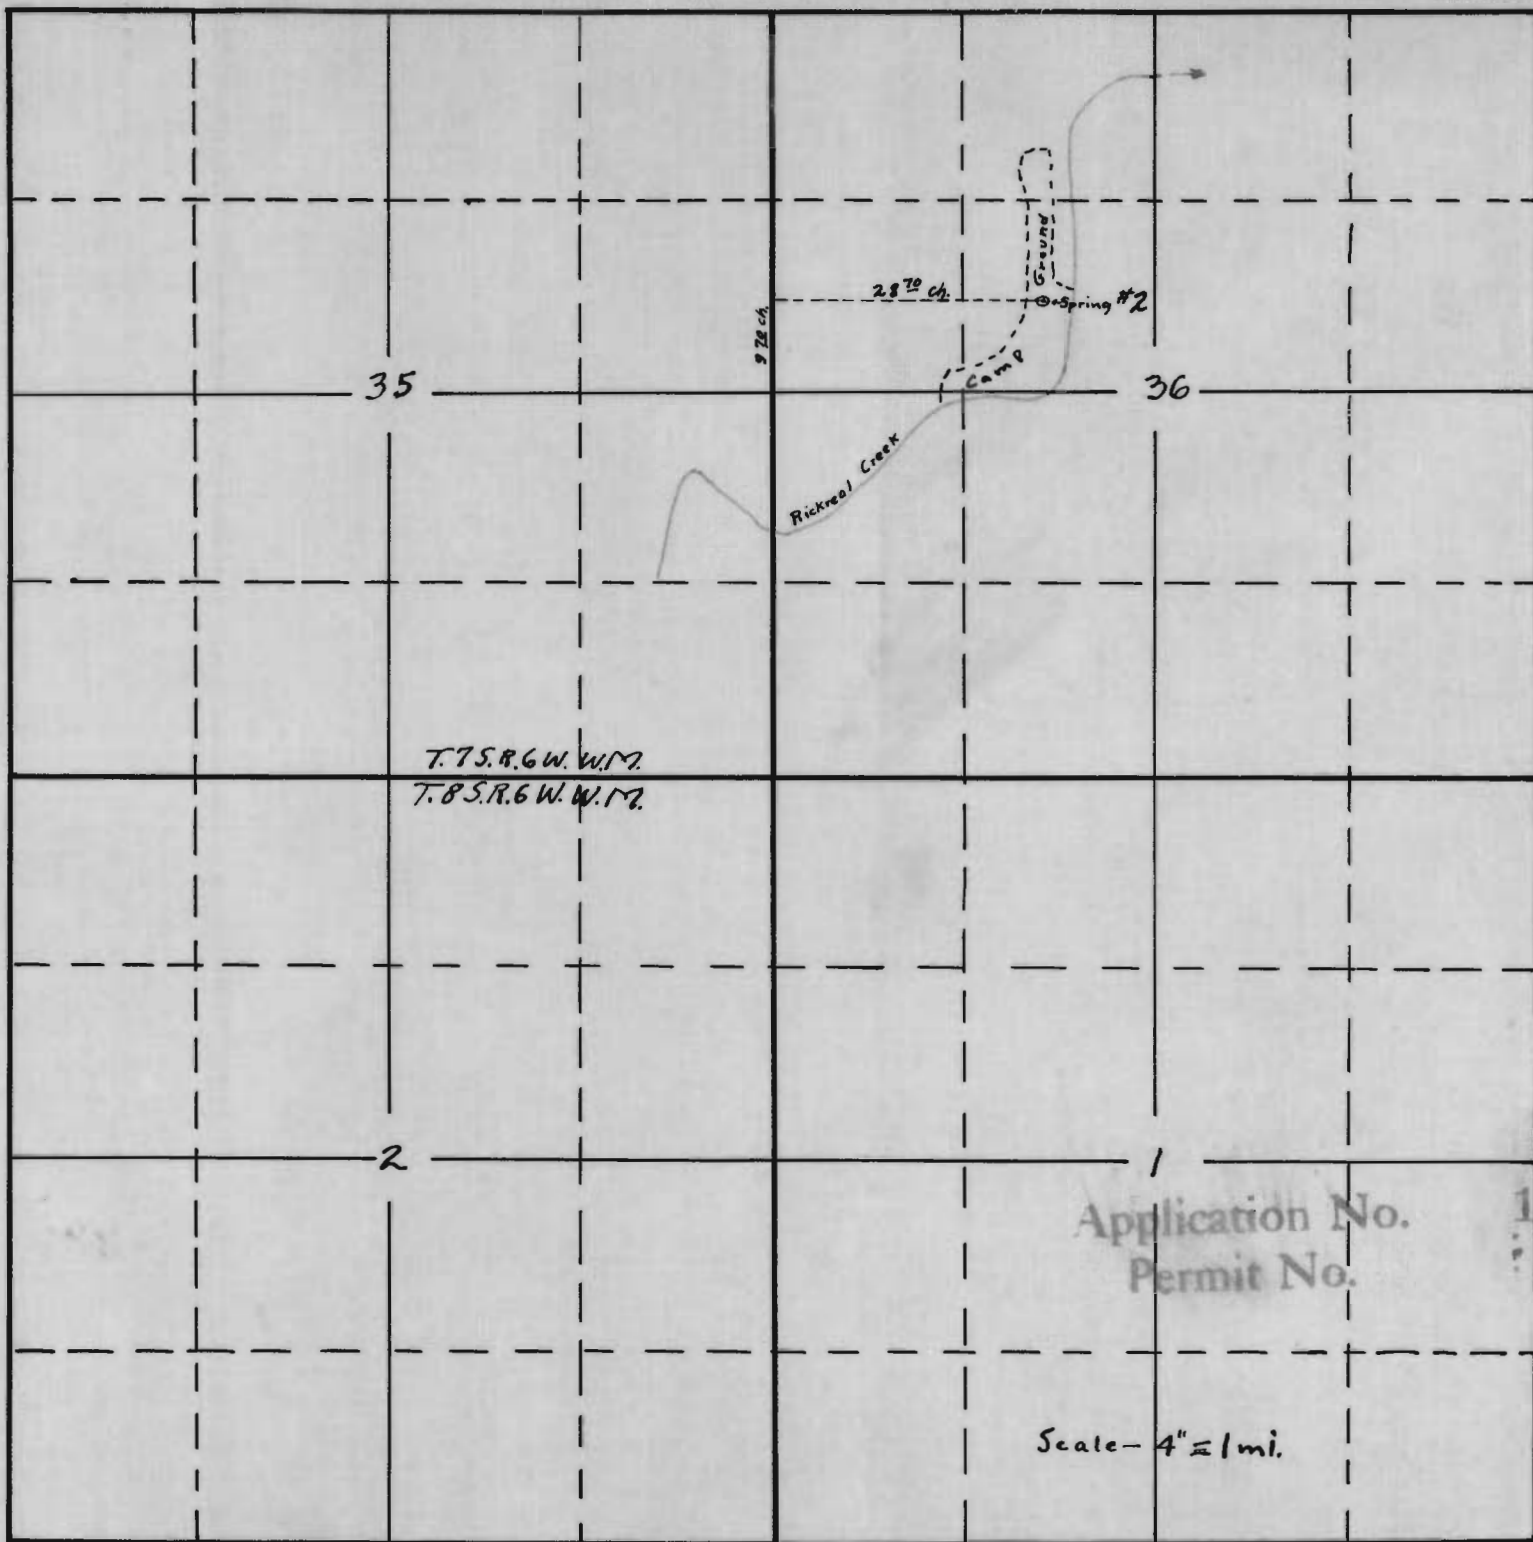

Scale - 4" = 1 mi.