


11488

North
↑

N.W. Cor. Sec 8

11488

Sec 8. T.2 S. R.2 E.

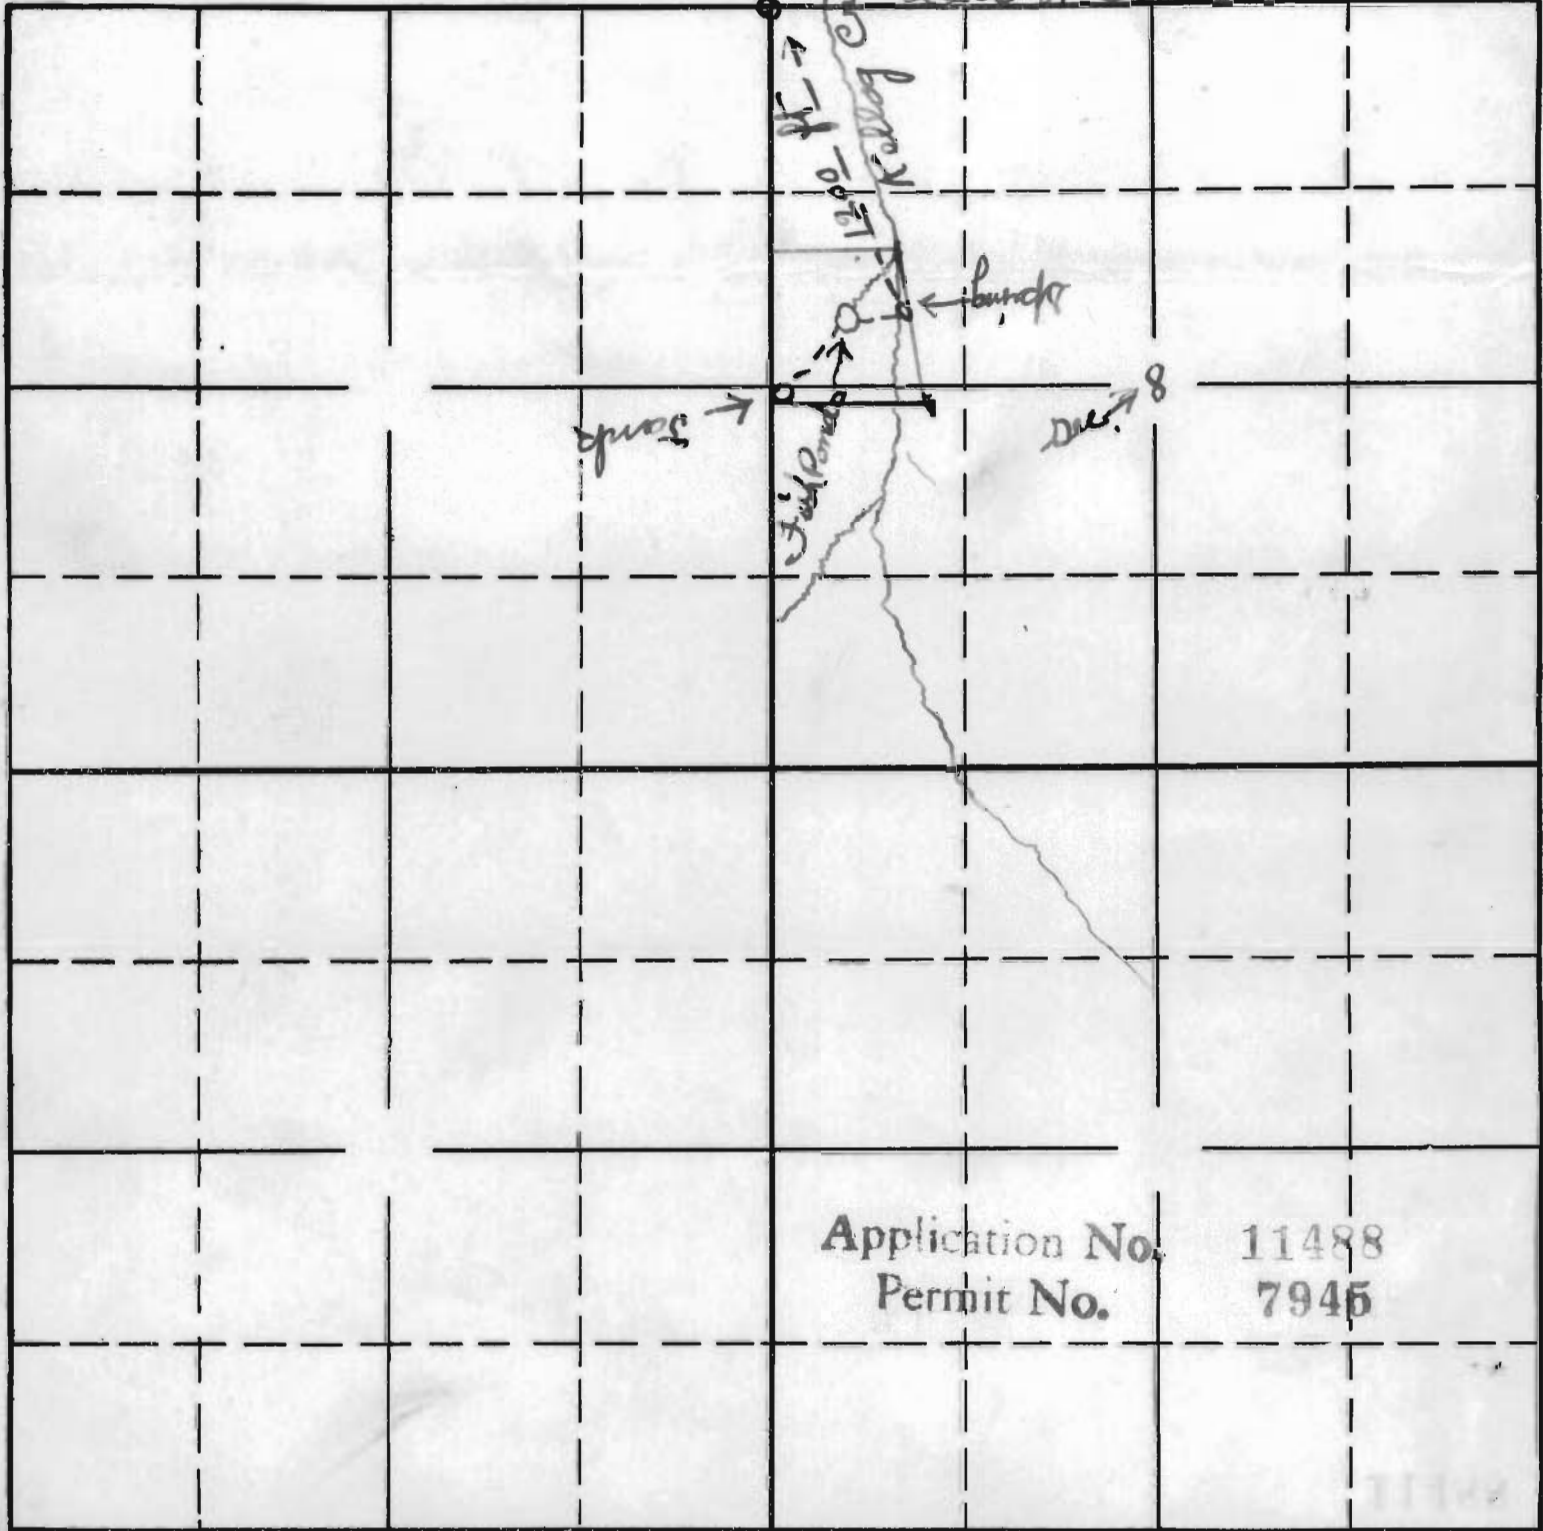

Sec. _____
 Tp. _____
 R. _____

N.W. Cor Sec 8

North

Sec 8, T. 2, R. 2, E. of the W.M.

Street

1200 ft


Spring

↑

Sec. 8

Sec 9

Sec. 8

Tp. 2

R. 2 E

Amended Map -
Permit No. 7945 -
Filed August 28th, 1928

App. No 11488,
Permit No. 7945