



Application No. 11499

Permit No. 7951

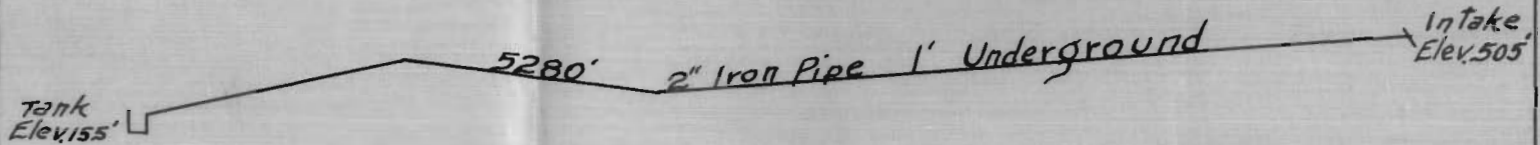

T. 3. N. R. 9. W.

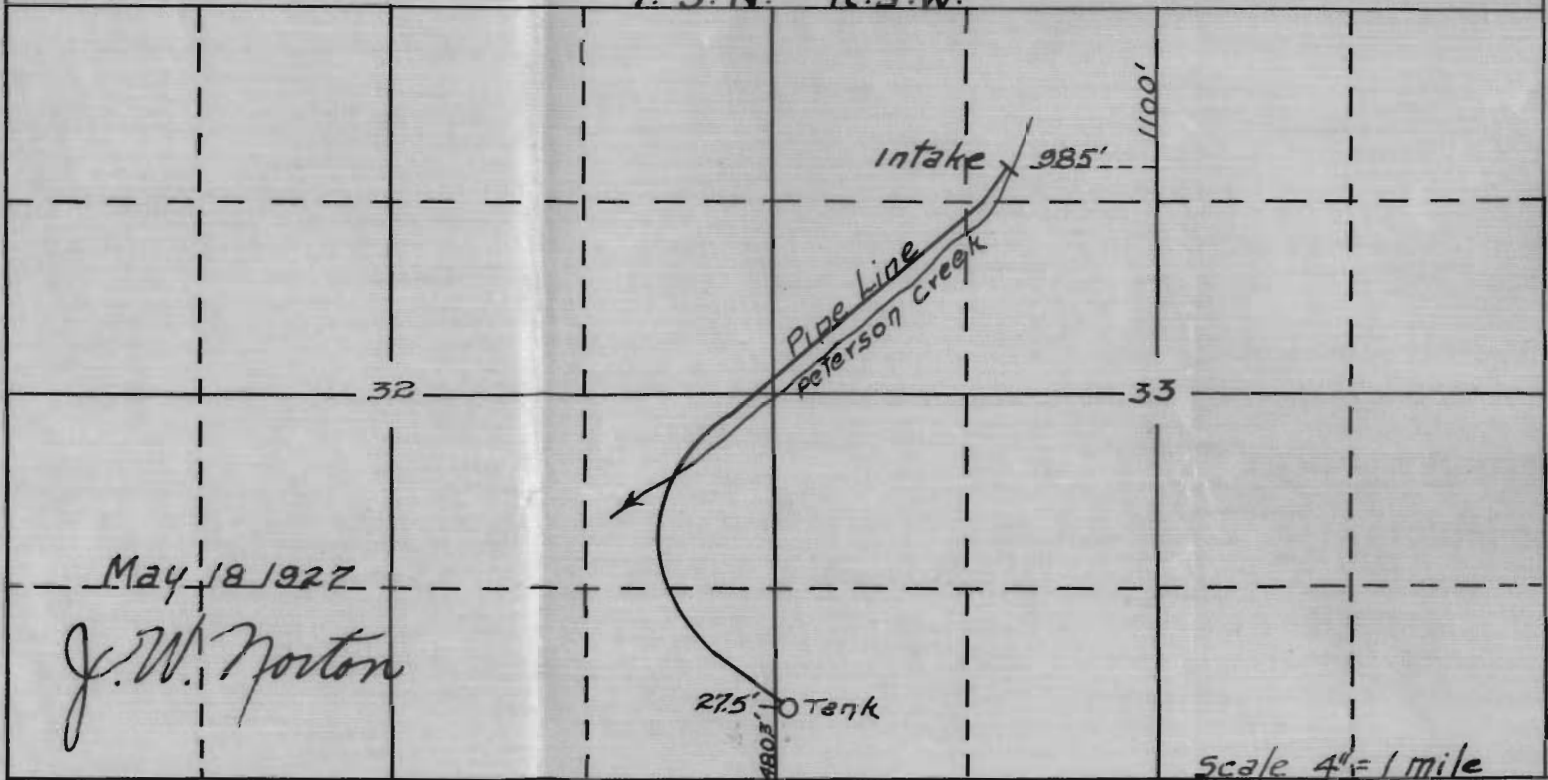

May 18 1927

J. W. Norton

Scale 4" = 1 mile