


11428

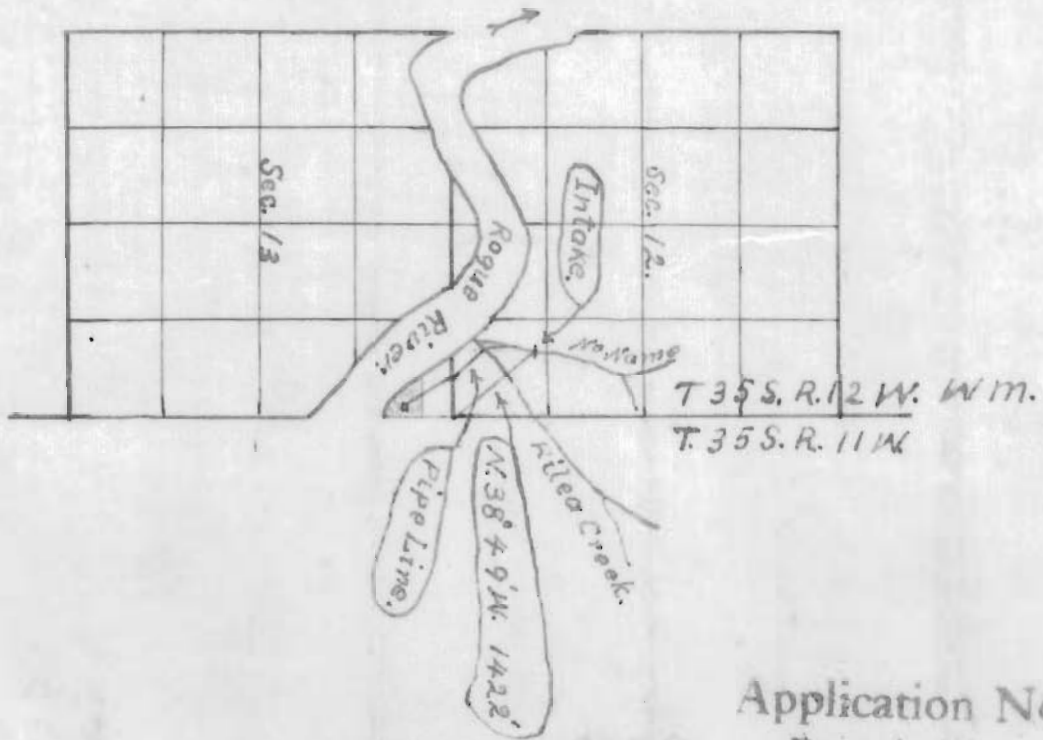

Application No. 11458  
 Permit No. 7958