


SECTION

TOWNSHIP 9S, RANGE 10E, W. M.

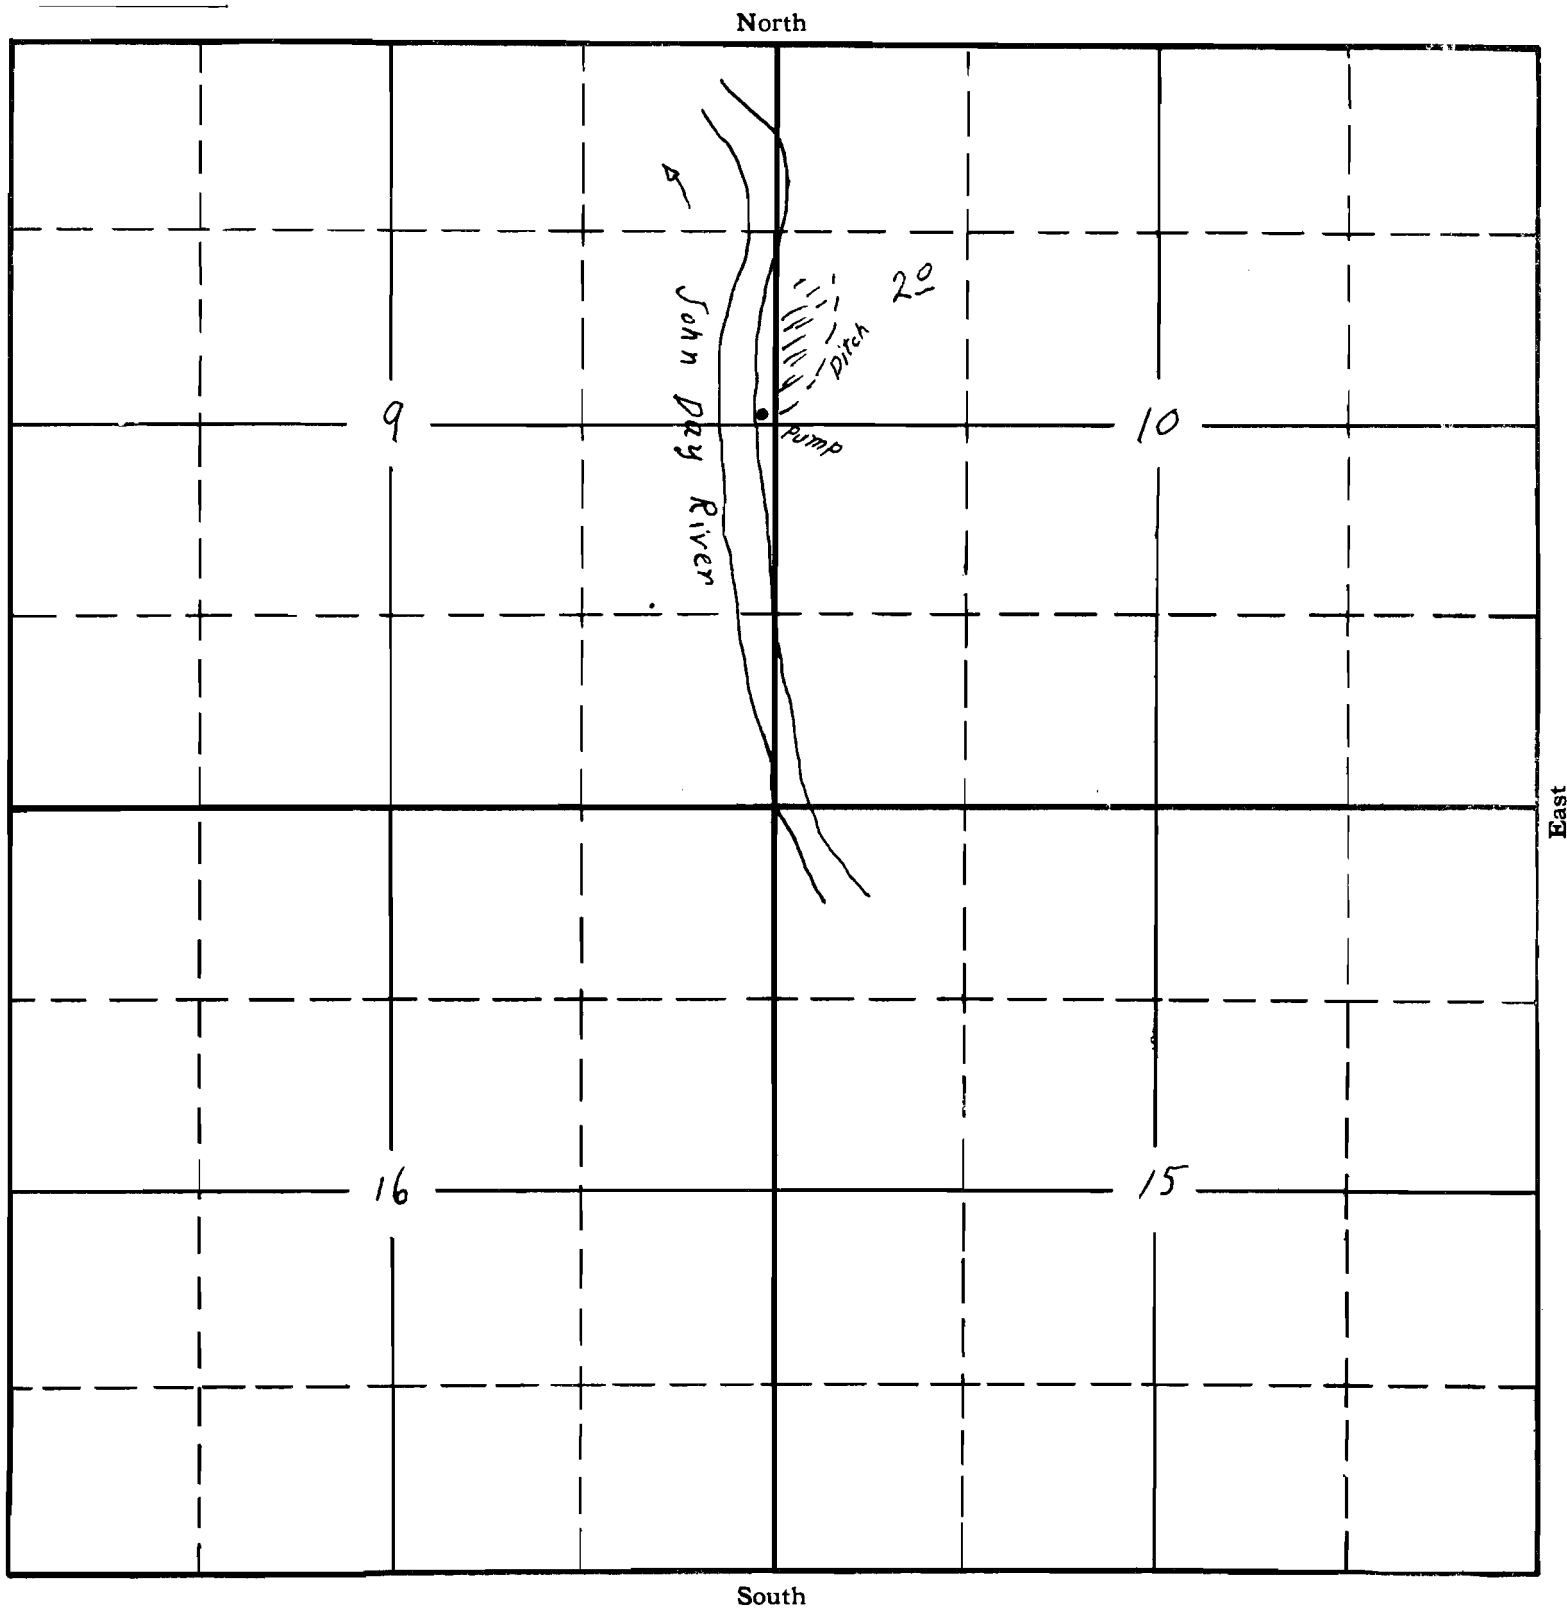

Map to accompany
Application of
Mrs. Blanch Hill

APPLICATION No. 11572
PERMIT No. 8011