
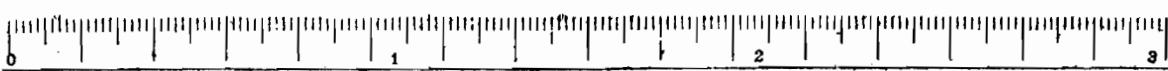


Township 4 South,

Range 12 East W.M.

Map of Frank Magill

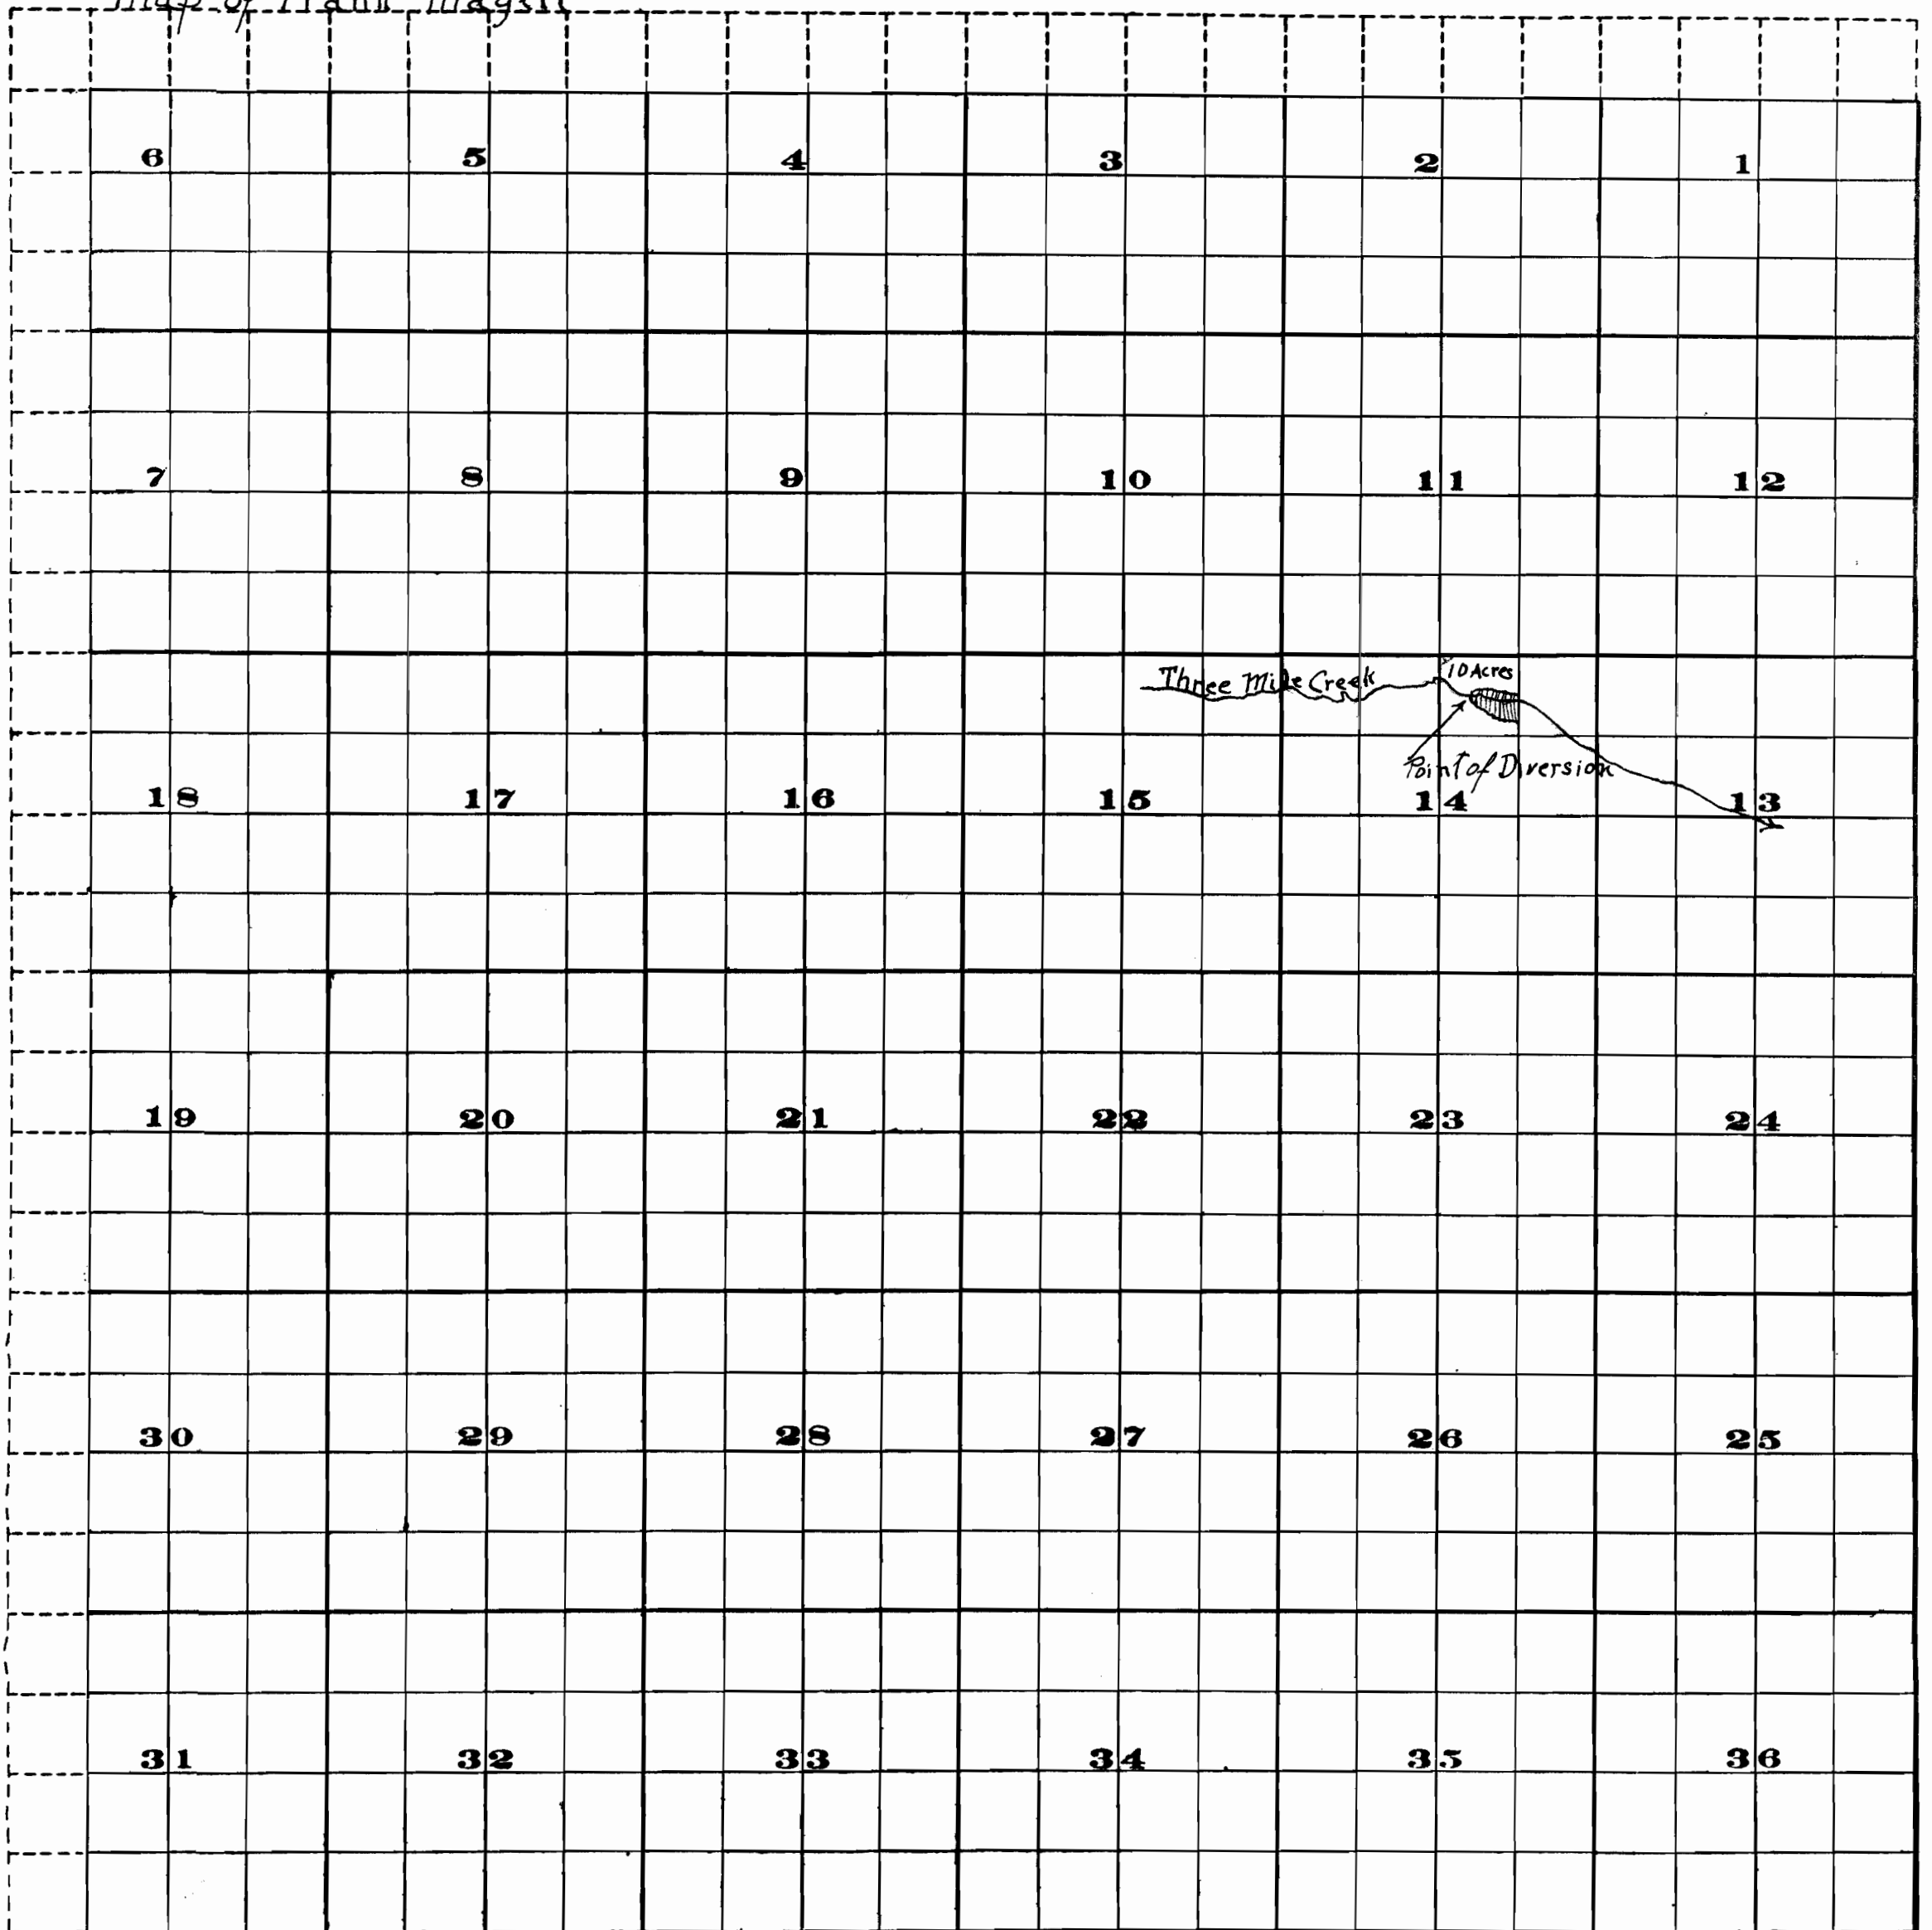

Scale of Feet.

FROM OFFICE OF THE STATE ENGINEER, SALEM, OREGON

Application No.

Permit No.

15  
19