

Sec. 19

24


Tp. 37 S.

R. 5 W

6 W

N. M

Permit: S 8041  
Volume: 7  
Strm: MURPHY CR  
Trib: APPELEGATE R  
Priority: 7/05/27

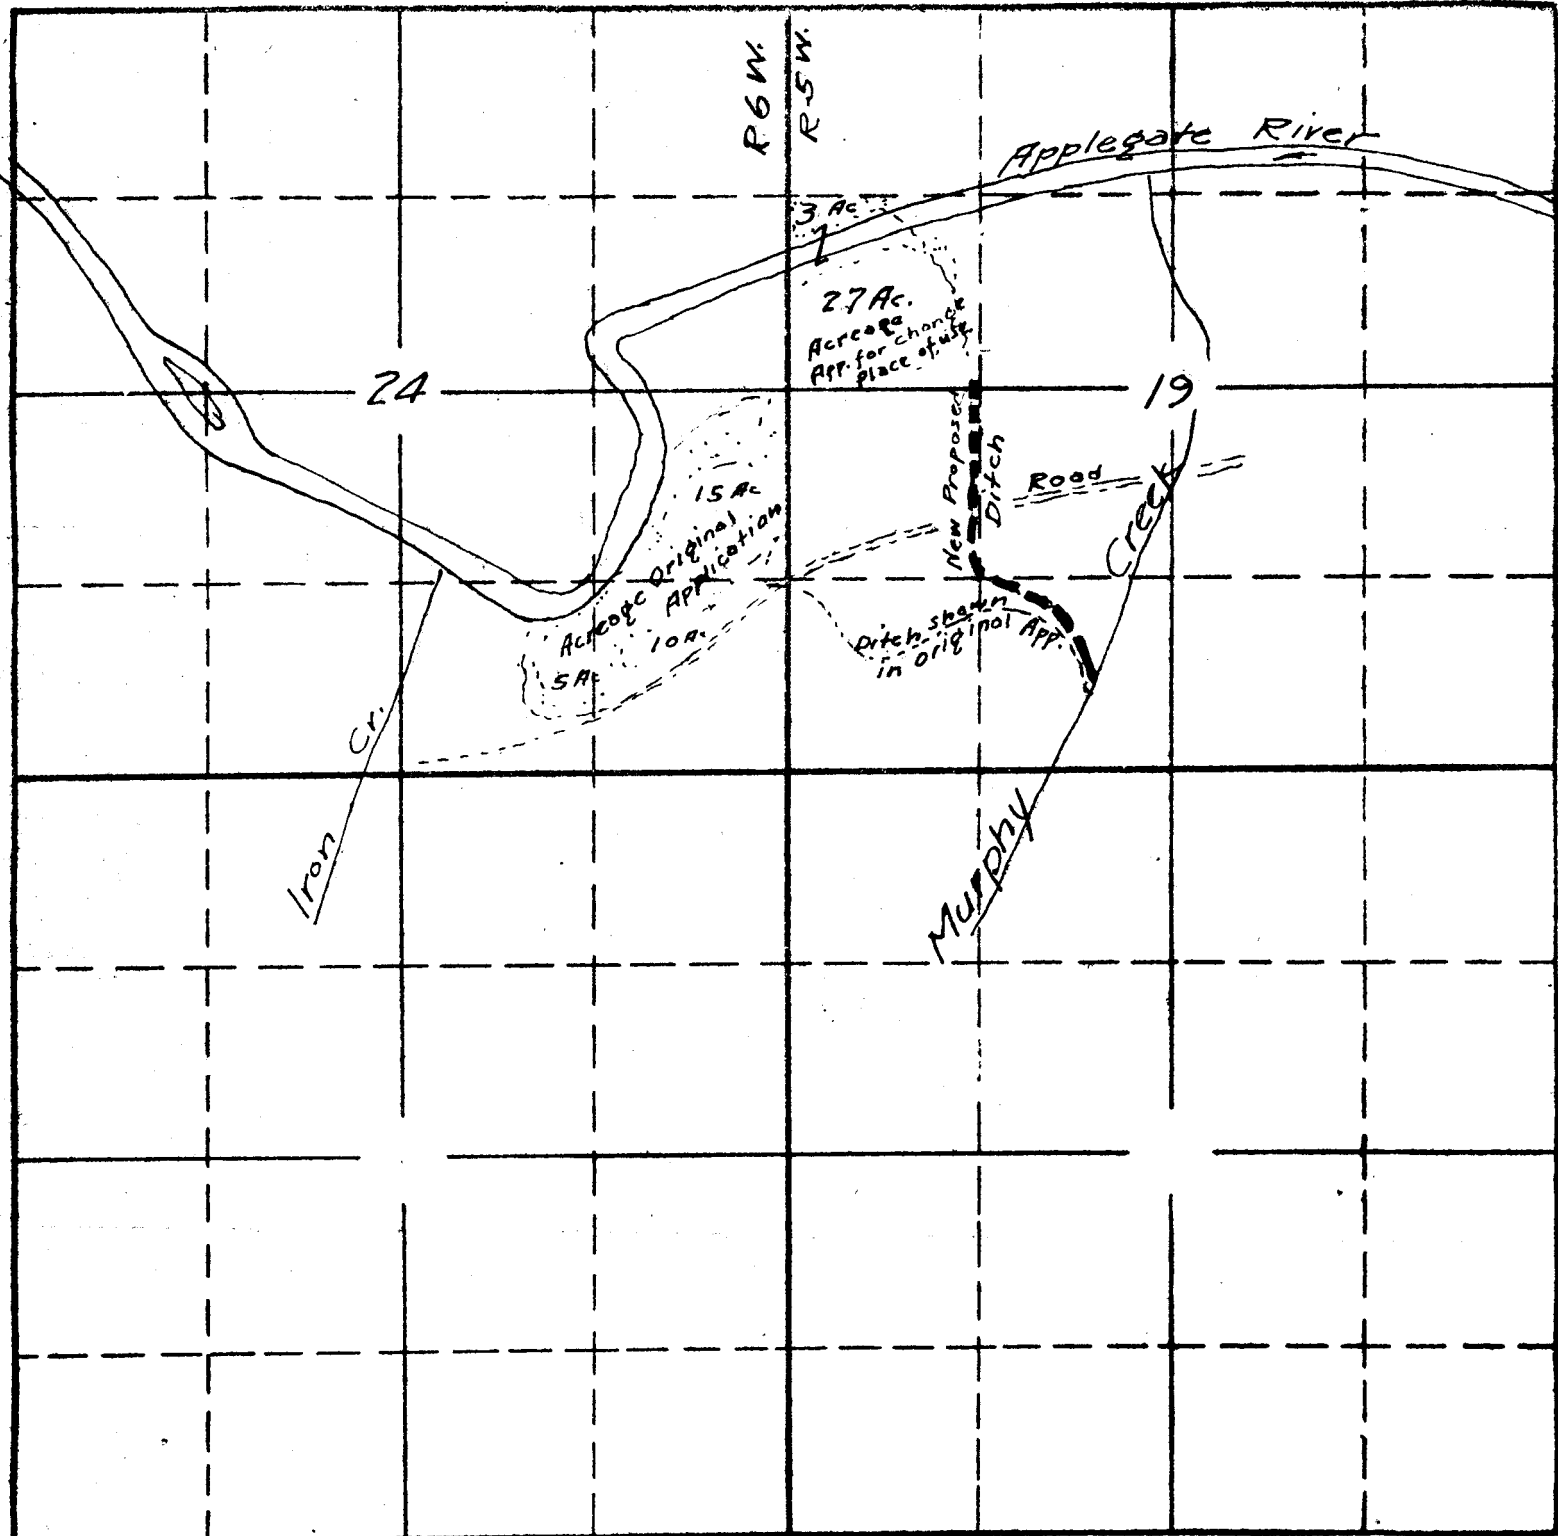

Amended Map.  
Filed Sep. 20, 1924

Map for J. L. Davis  
showing proposed  
change for place of use.

App. No. 11604  
Sec Permit 8041