


WASH. CO.

T. 25 R. 1 W. W.M.

T. 25, R. 1 E., W.M.

Tract B  
of Rosewood Acres CO.

Lot 9 of CLACKAMAS CO. Rosewood

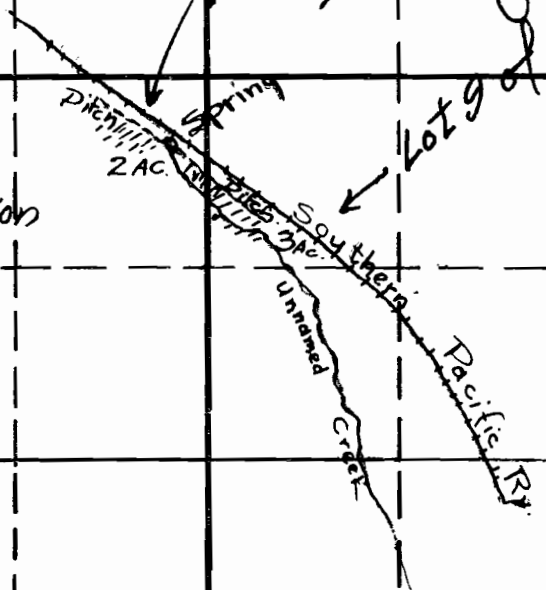

MAP  
Accompanying Application  
of G. A. Gabe of  
Tigard, Route 1.

13

18-  
19

Corrected  
A/12/35 - see  
letter of date

Application No.  
Permit No.

1017  
101