


Twp 13 SR 28

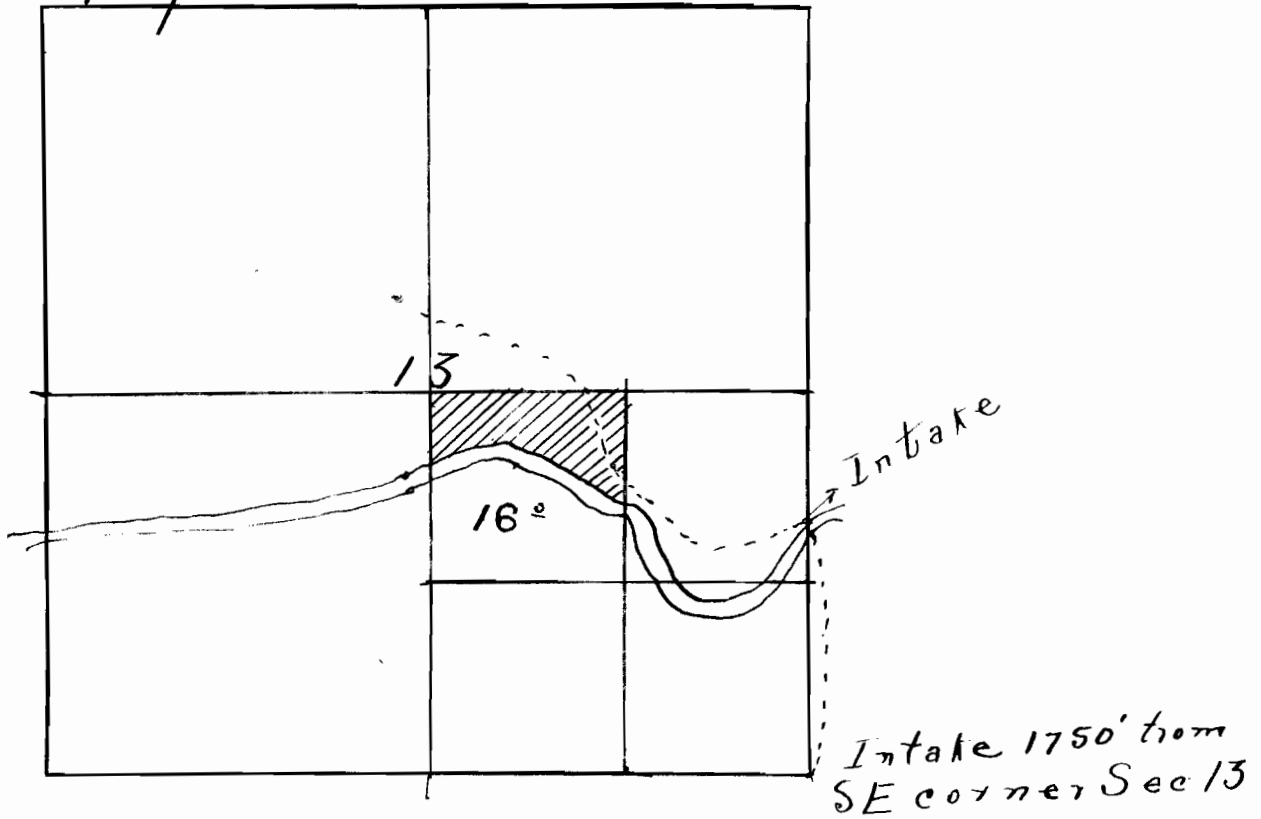

Application No

Permit No.

11777

8188

11777

8186