


Application No. 1649

Permit No. 823

Township — 11L — South Range — 11L — East W. M.

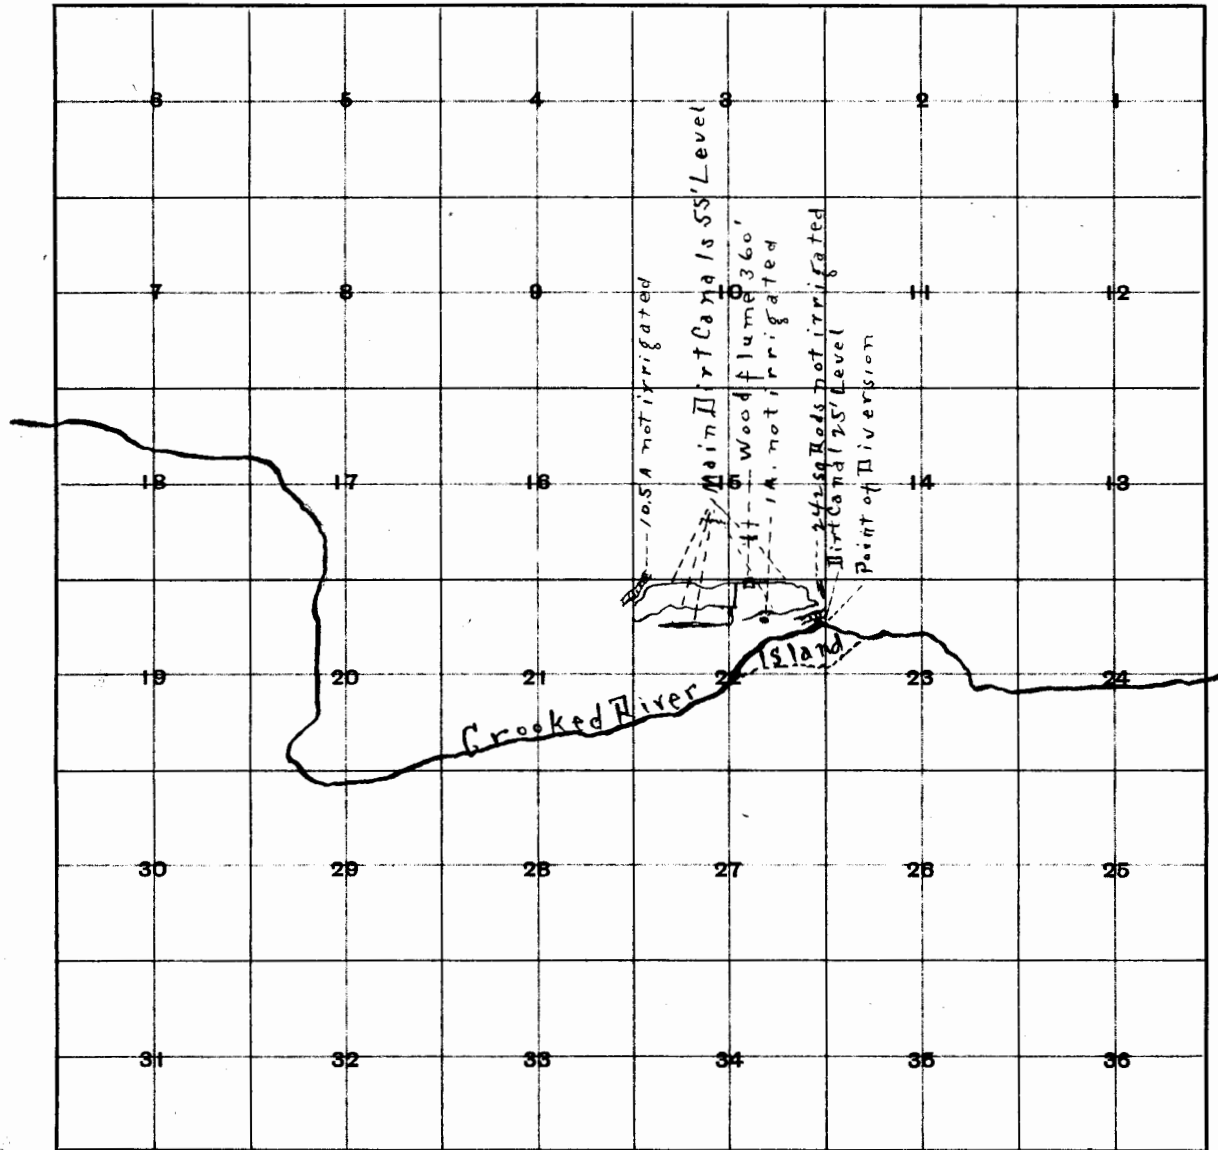

Scale—One inch to mile

Amended Map filed with
Proof E J Tirrill Irrig. Project