


Sec. 10

Tp. 5d.

R. 3 E.

70

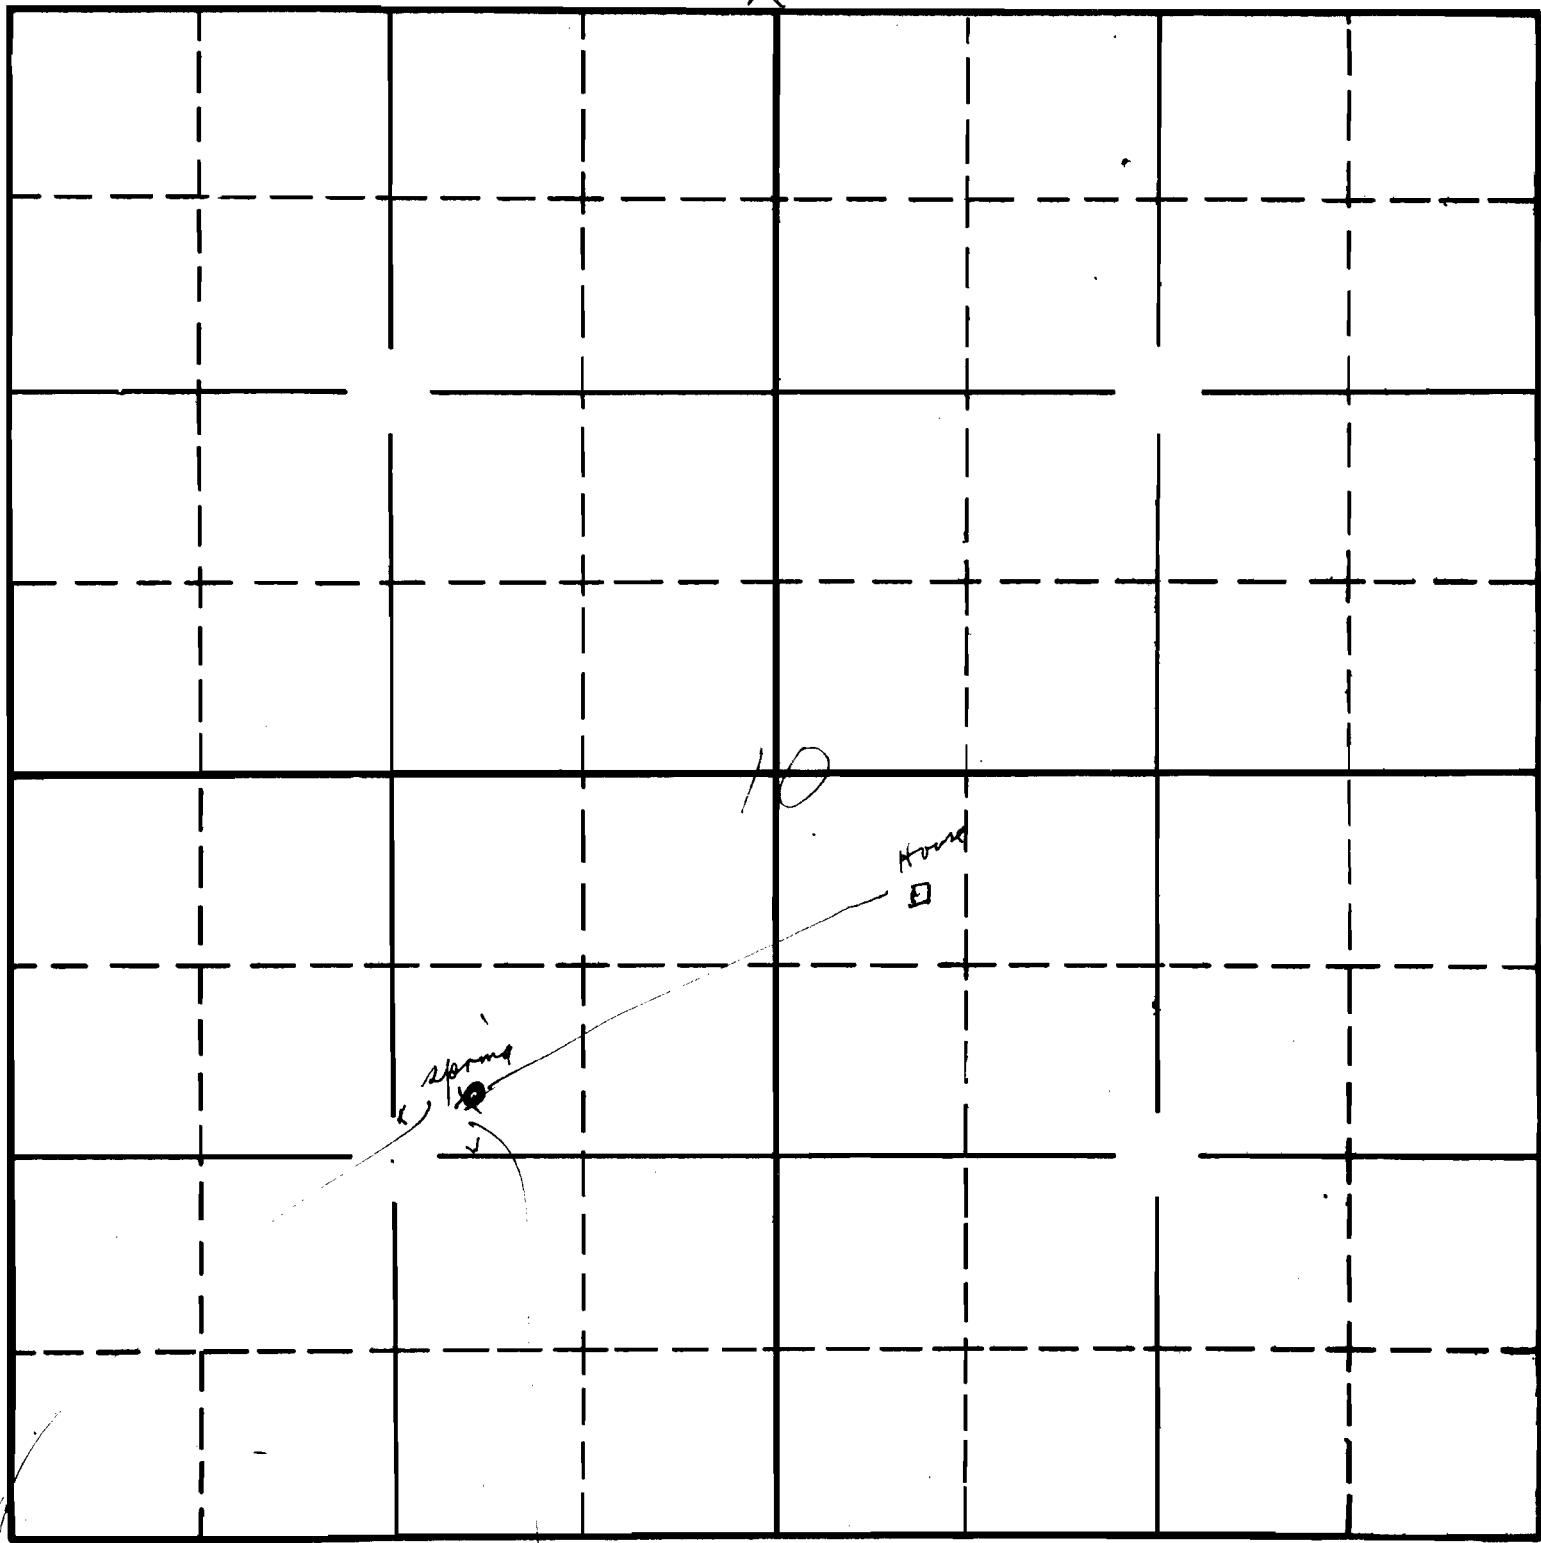

W

E

10

House

Spring

625 ft

450 ft

Application No.
Permit No.

11867
8251