


T. 14 S., R. 14 E.


TN 14 S. R 14 E

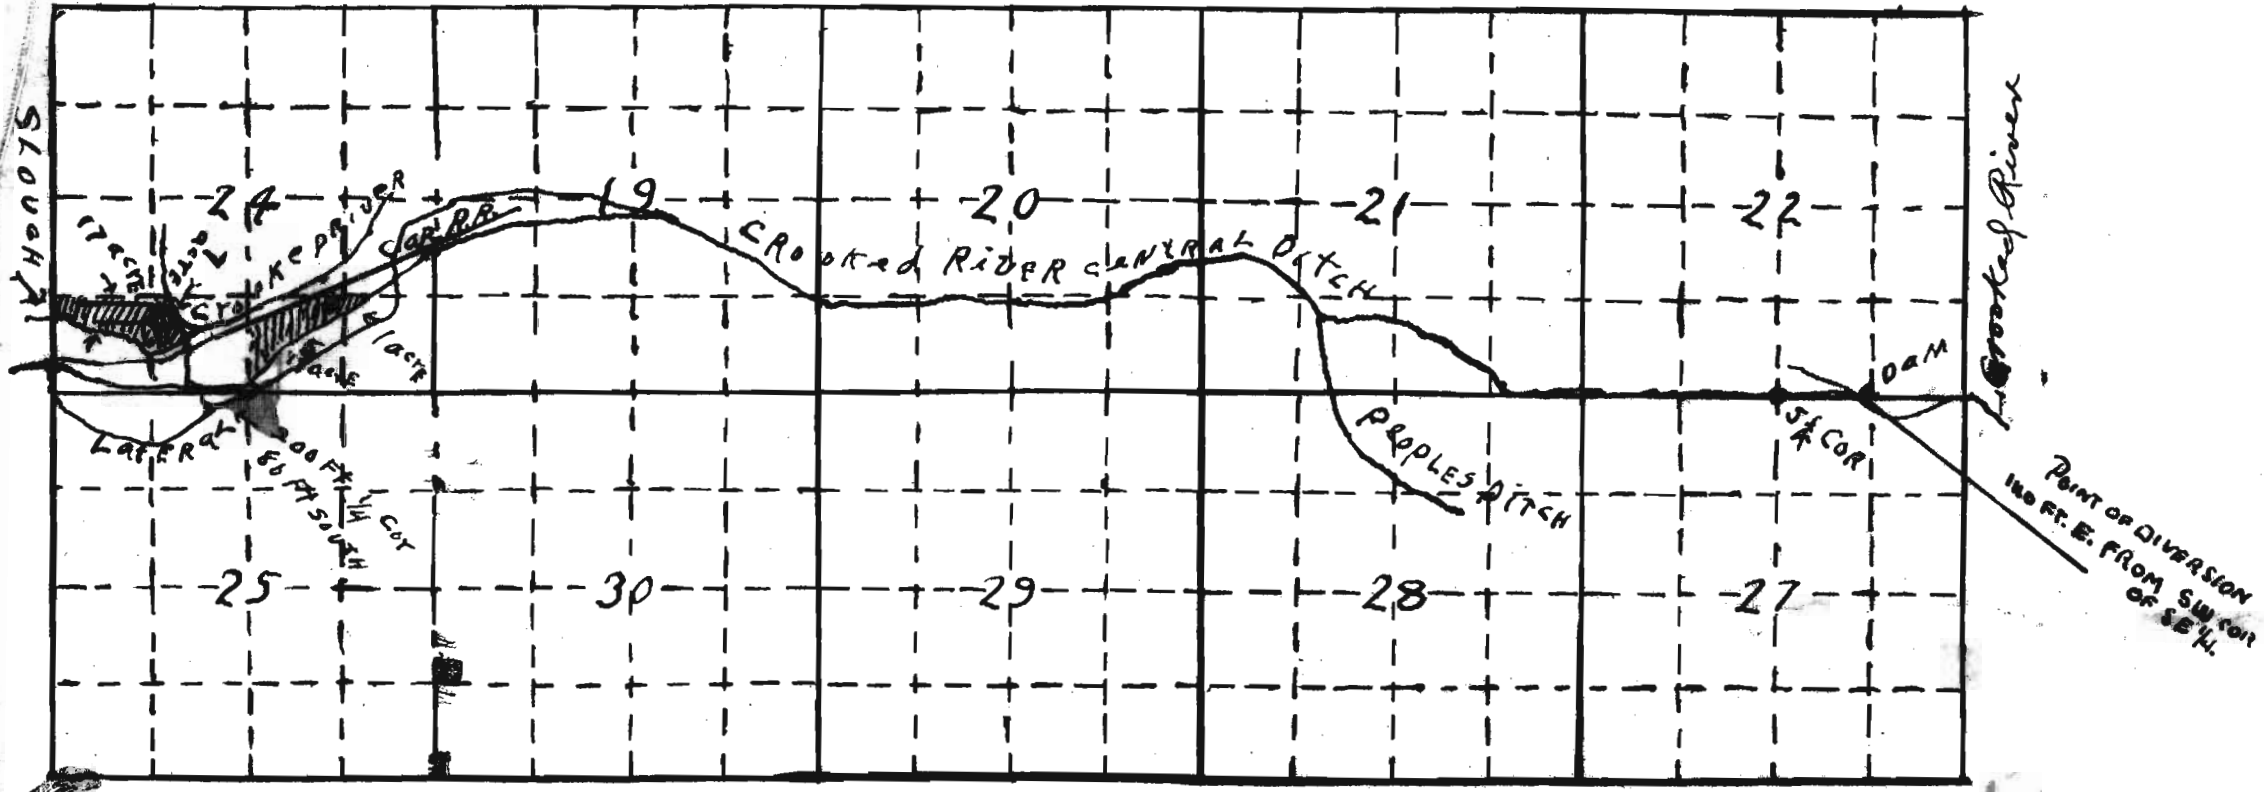

Application No. 11872
Permit No. 8253

T. 14 S., R. 14 E.

TN 14 S R 15 E

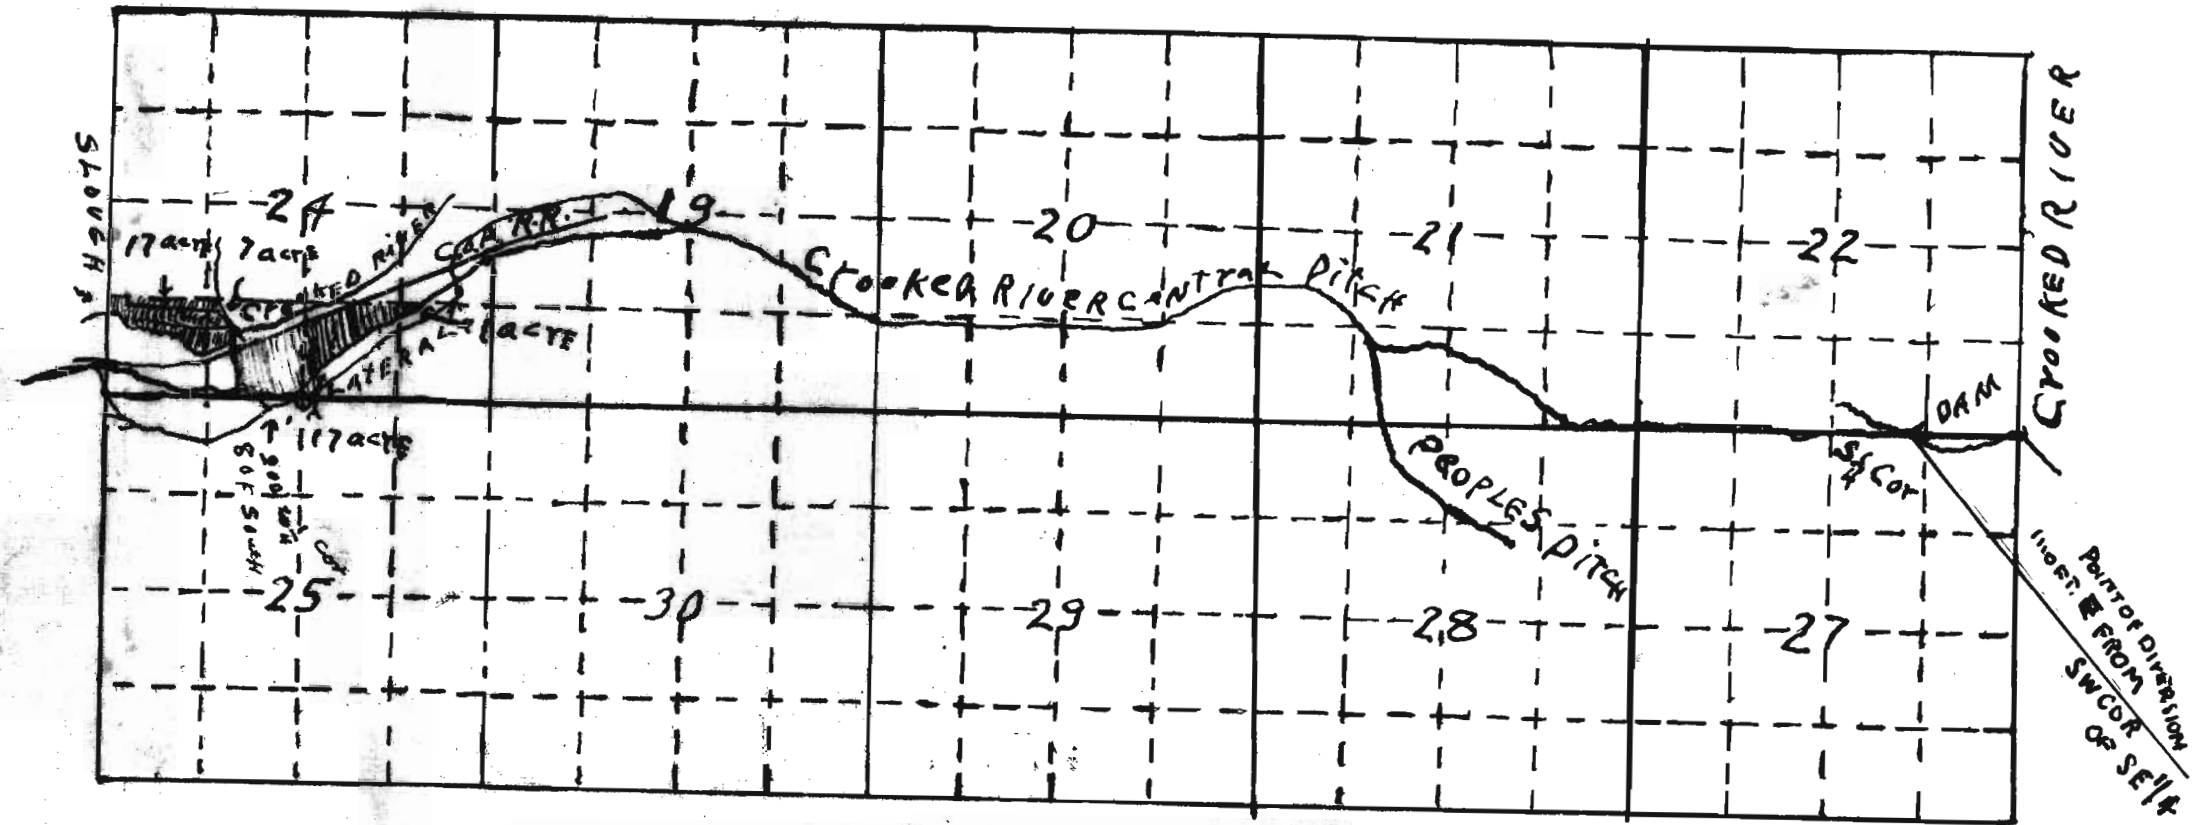

Application No. 11872
Permit No. 8253

11872