


Map

Accompanying Final Proof of Permit No. 8266 Application No. 11859
to the waters of an unnamed Creek Tributary of Trail Creek
tributary to Rogue^(River) Jackson County Oregon for irrigation
purposes.

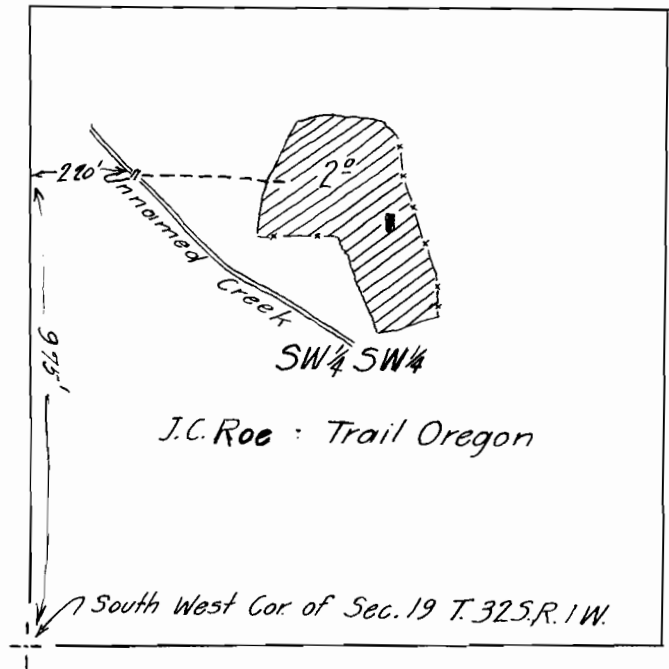

Map made from Plane Table Survey
made by Chester A. Cummings