


Sec. 13  
14  
23  
24  
 Tp. 35.  
 R. 8 1/2 E

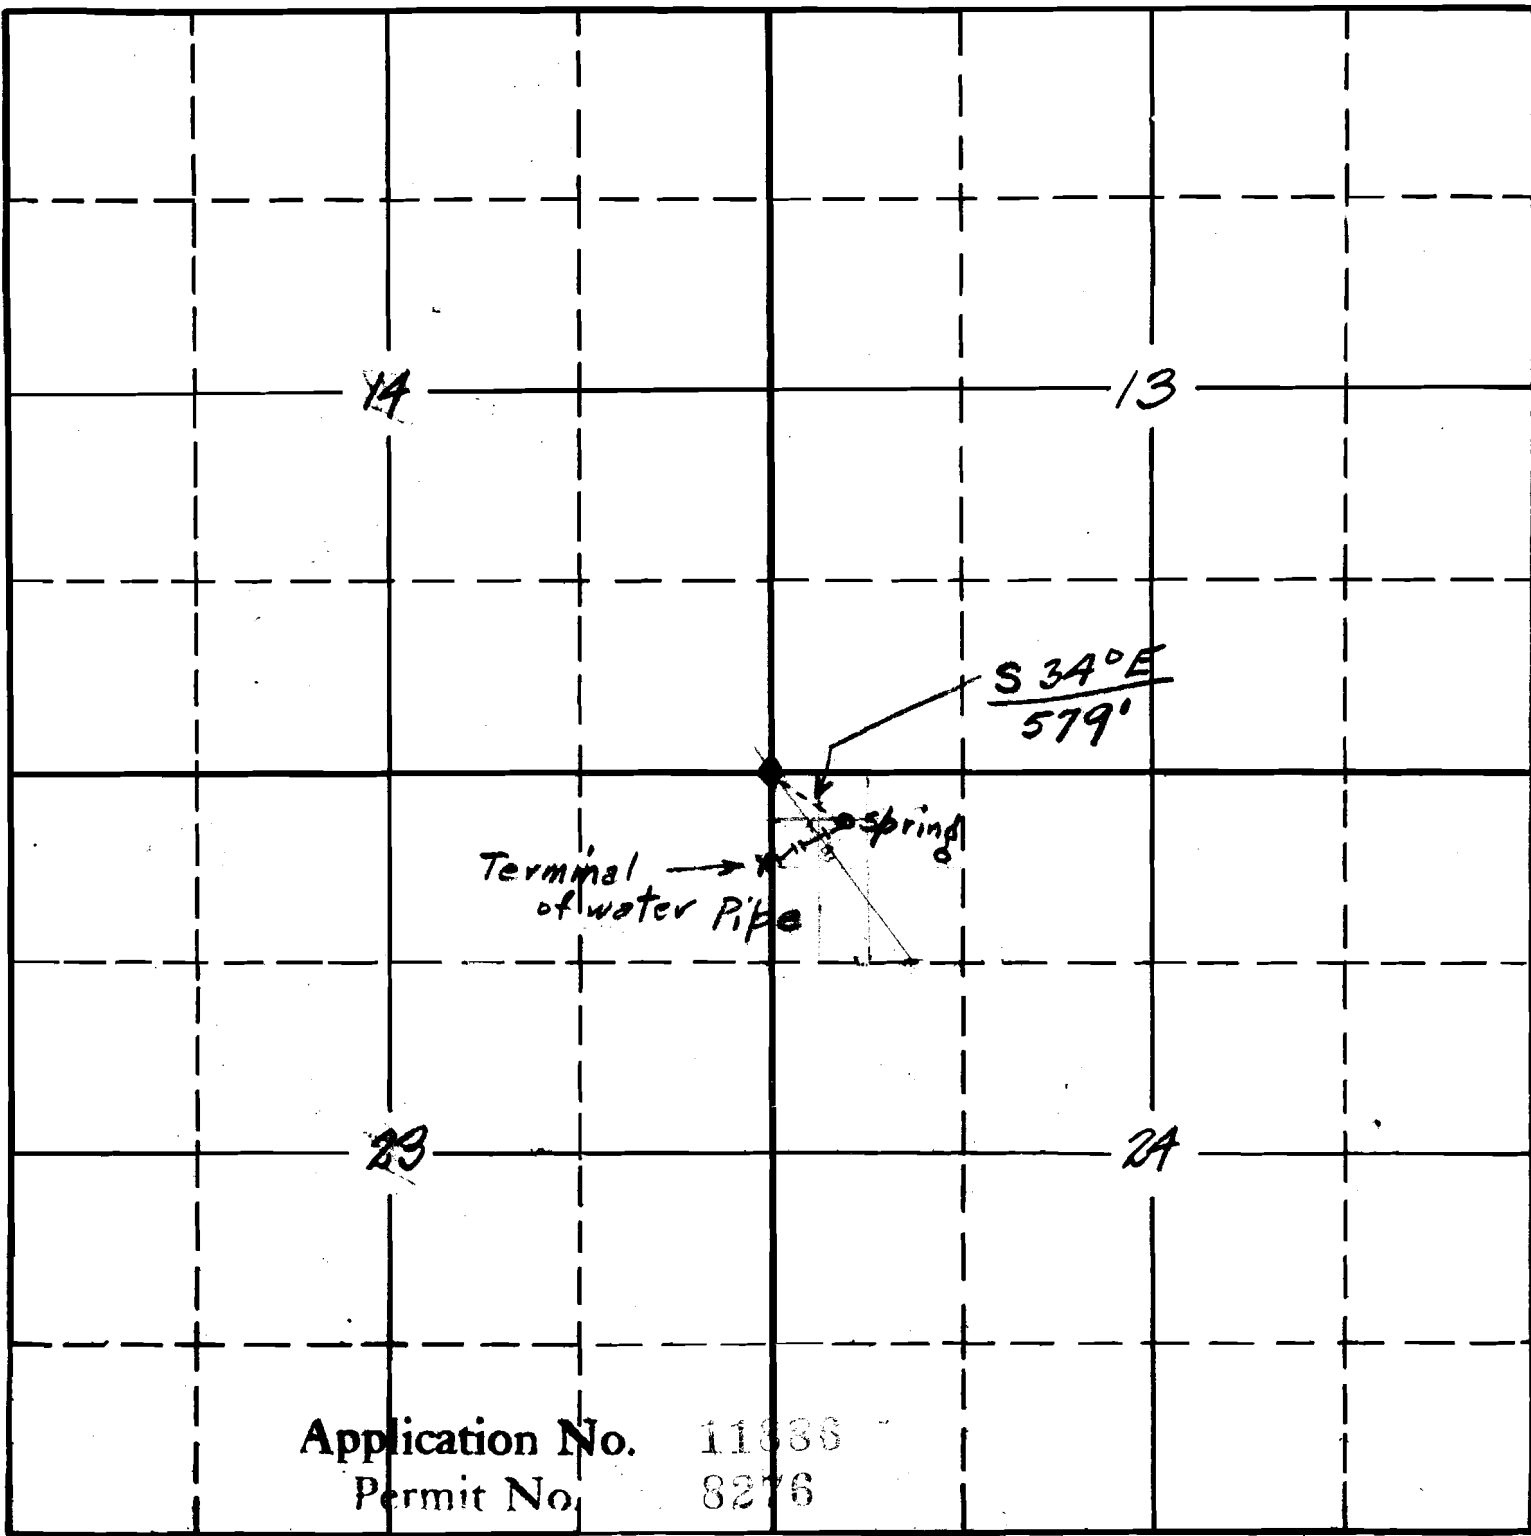

Application No. 11836  
 Permit No. 8276

The field work necessary to determine of this map was accomplished by a process of engineering methods, using a standard steel survey compass and 100 feet steel tape.  
 15th October 1927  
 Lawrence Williamson  
 Surveyor