


11905

Sec. 15

16

Tp. 18 S

R. 11 W

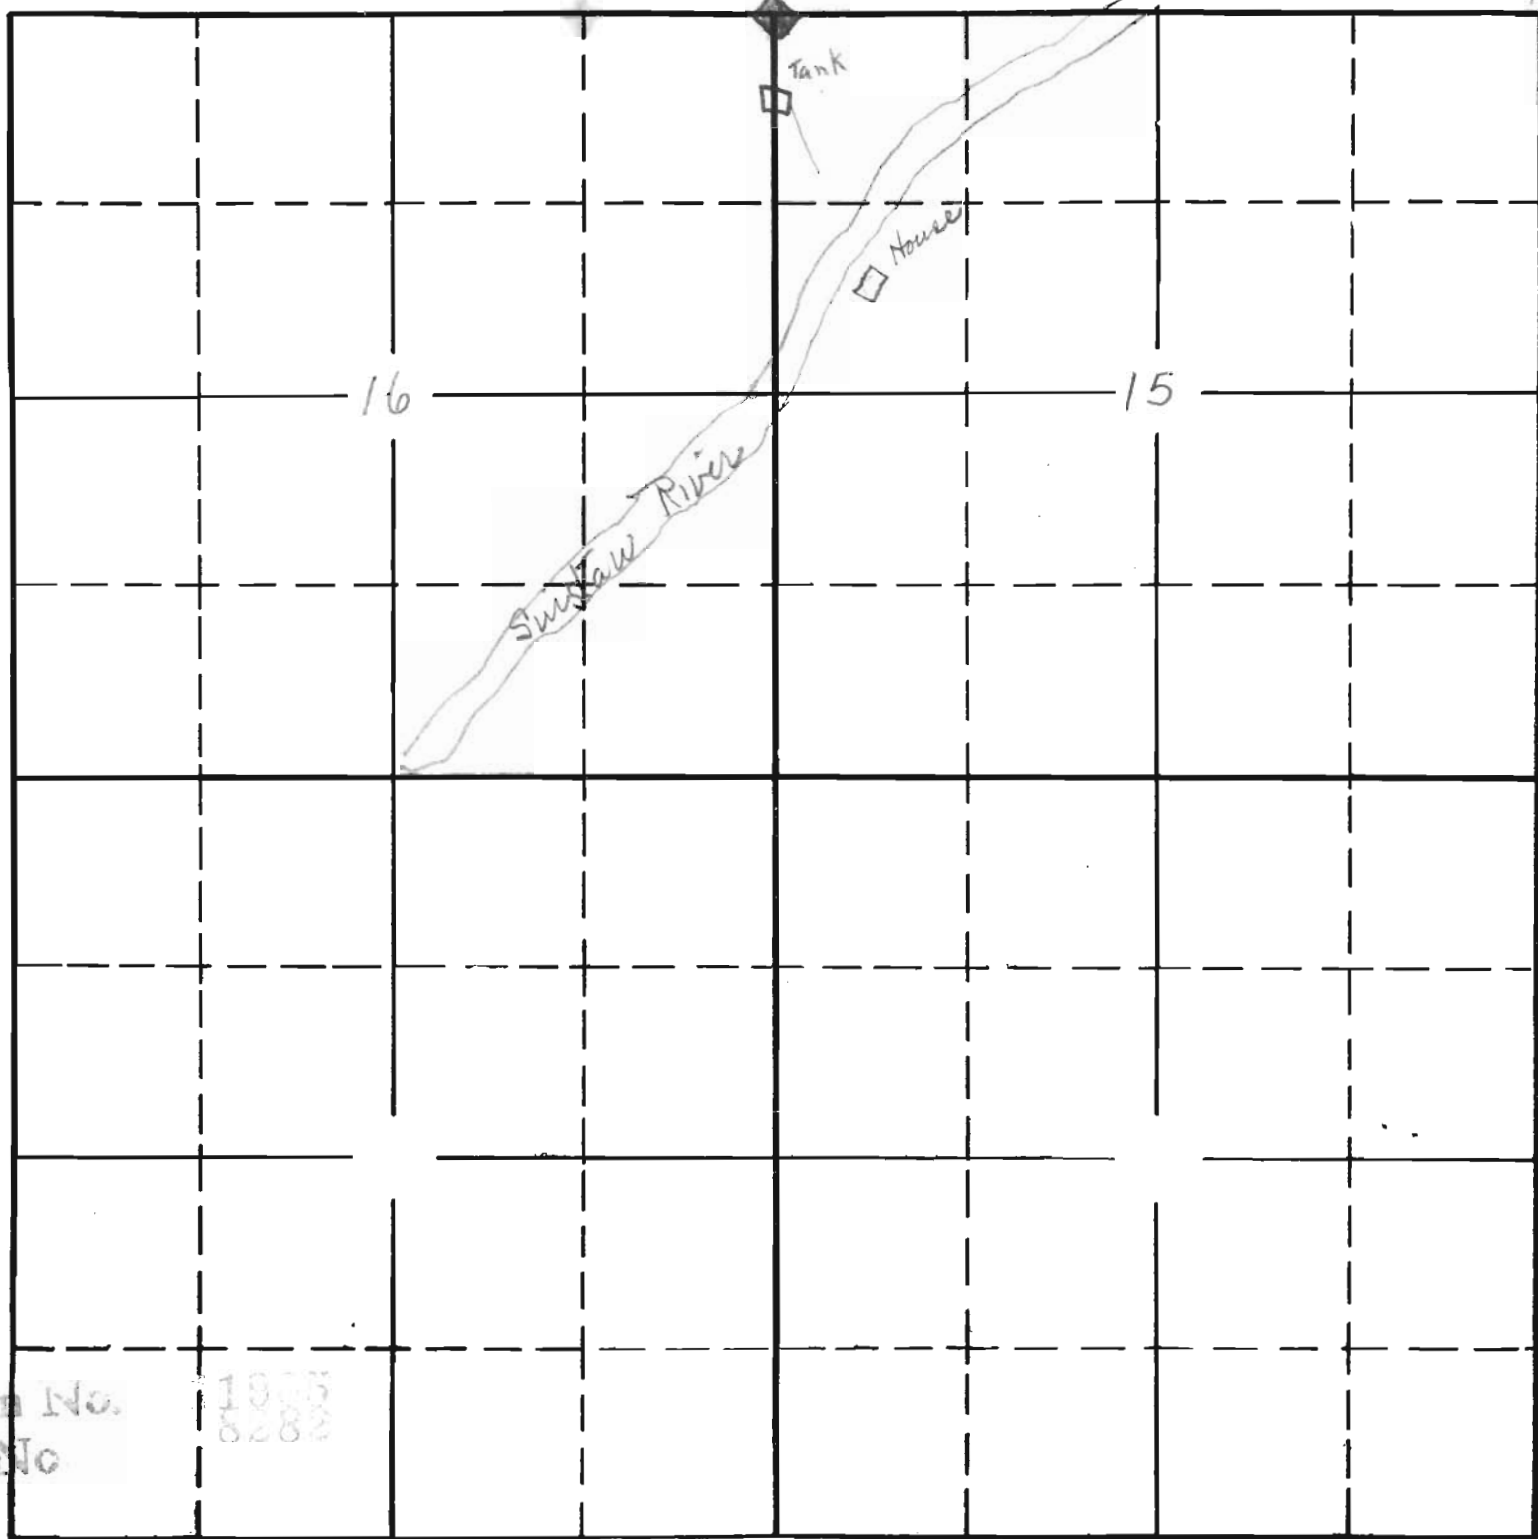

Application No.  
Permit No

1905  
8282