

UNITED STATES DEPARTMENT OF AGRICULTURE  
FOREST SERVICE

MAP SHEET

No. \_\_\_\_\_

Umpqua National Forest.

Division \_\_\_\_\_

District \_\_\_\_\_, Block \_\_\_\_\_

T. 26 S., R. 3 W.


W. M., Section 19, Quarter \_\_\_\_\_

Mapped by D.H.M.

1-9-28

Scale: 8 inches = 1 mile.  
42.41 chs.

4.31 chs.

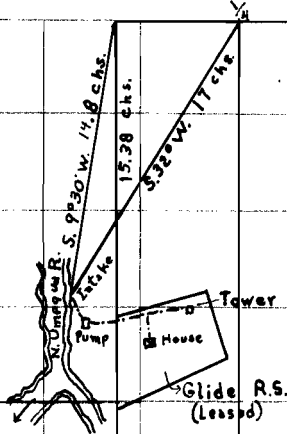

D. L. C. No. 42

41.88 chs.

38.11 chs.

Sec. 19

GLIDE R.S. WATER DEVELOPMENT