


Sec. 11

12

Tp. 8 S

R. 4 W.

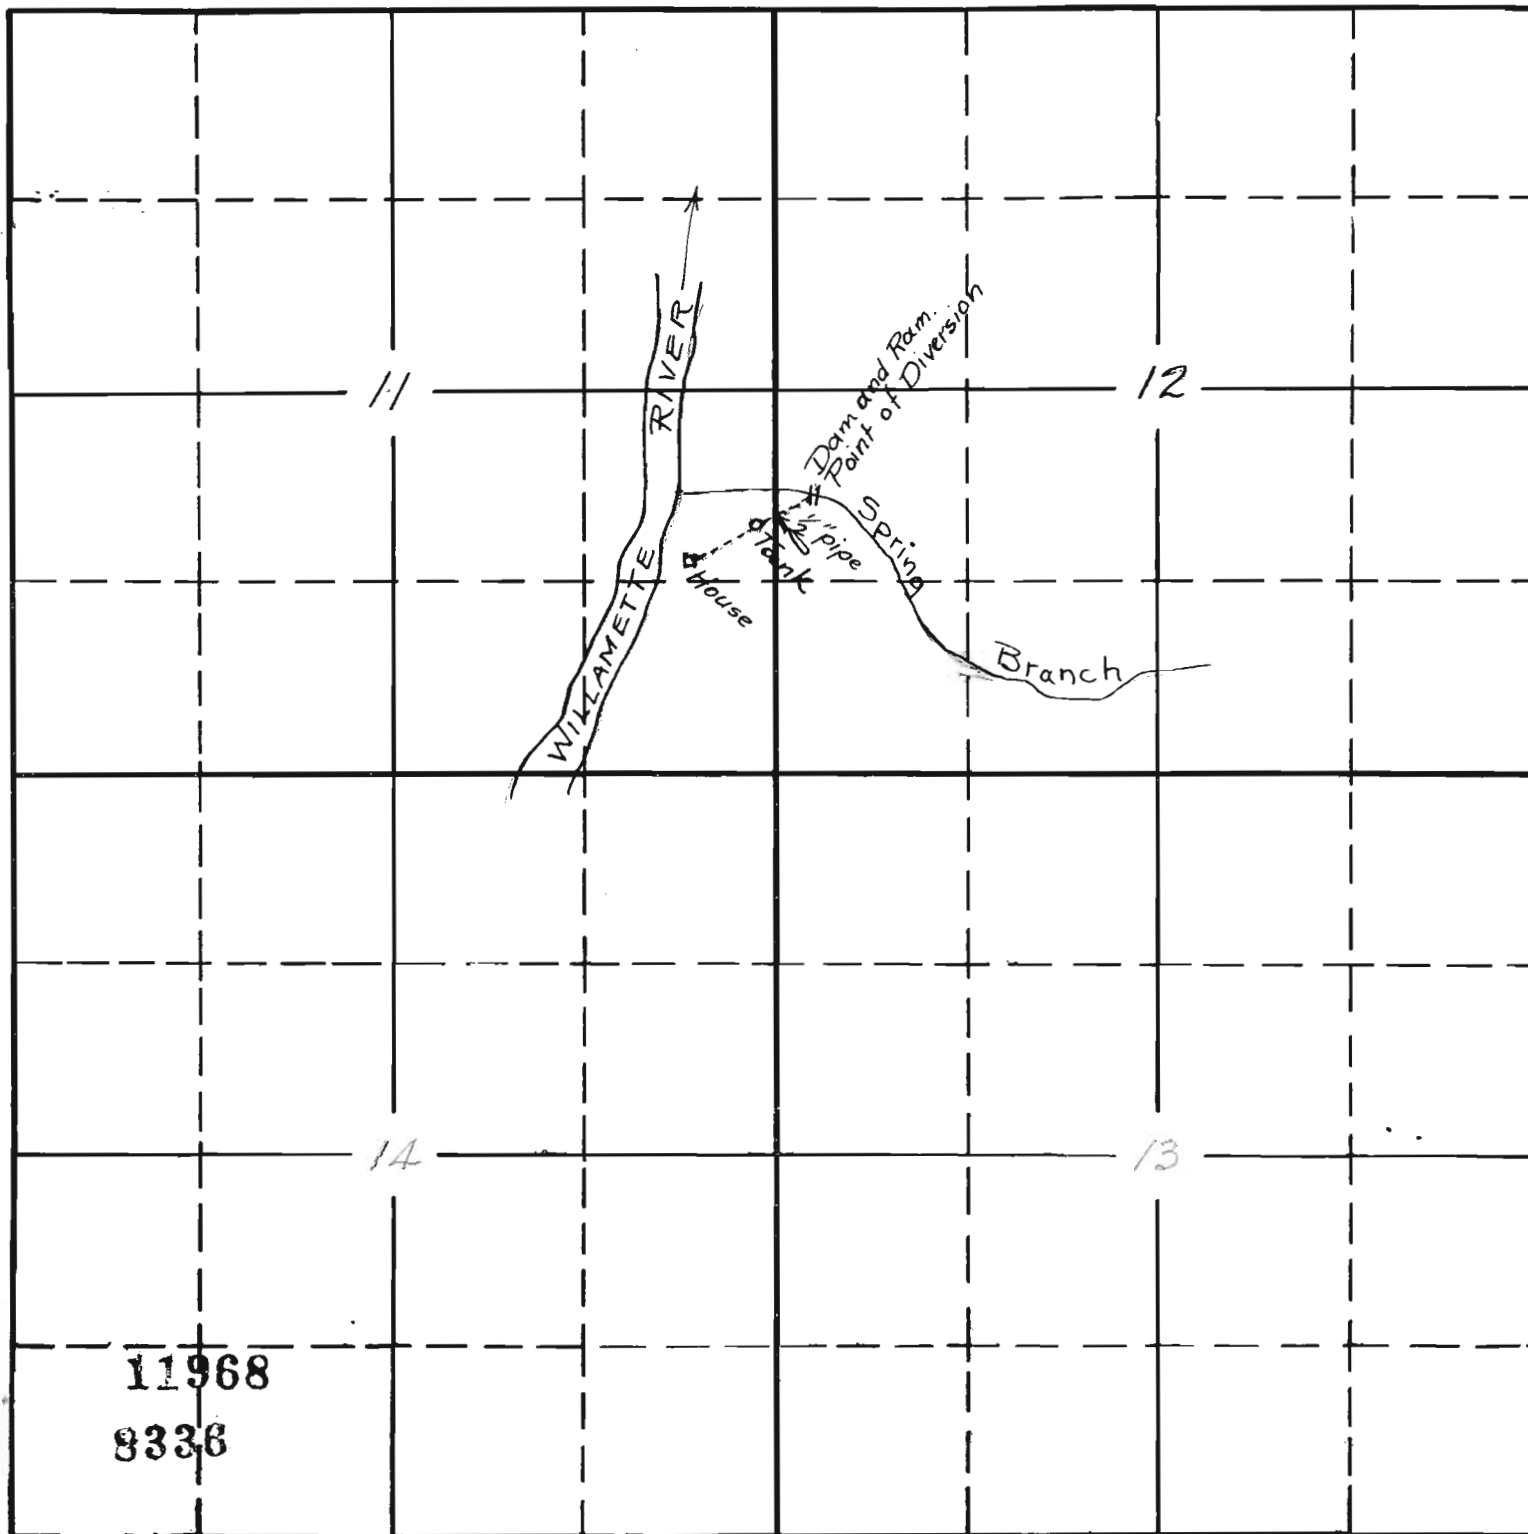

Application No.
Permit No.

11968

8336