


T. 39 S., R. 1 E., W.M.

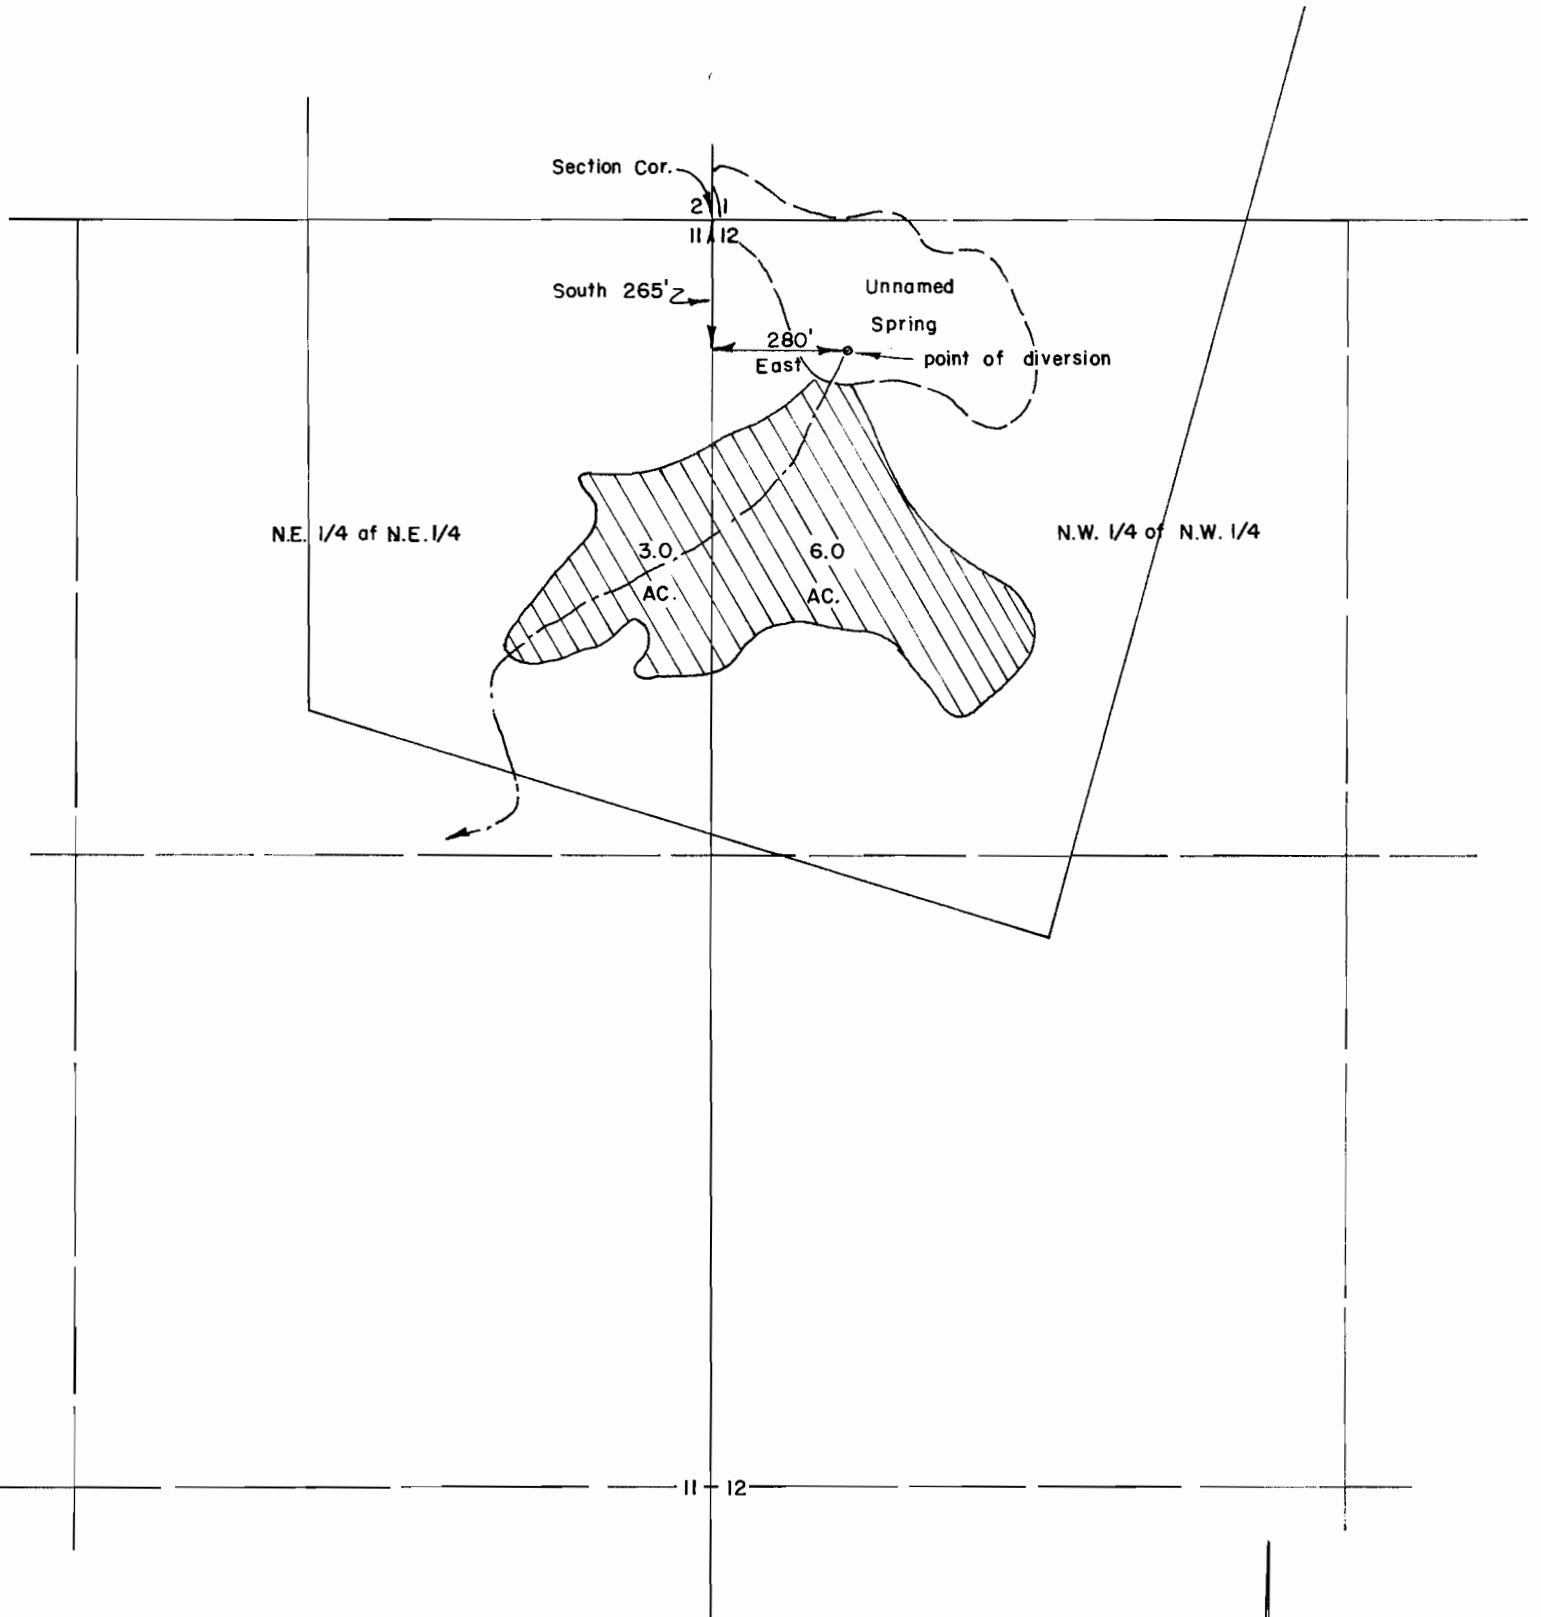


Map to correct lands under Permit No. 8367
For: Mark E. Boyden & Joan Neil Boyden
Nov., 1963



SCALE : 1" = 400'

N

Jr 39 SR 1 E

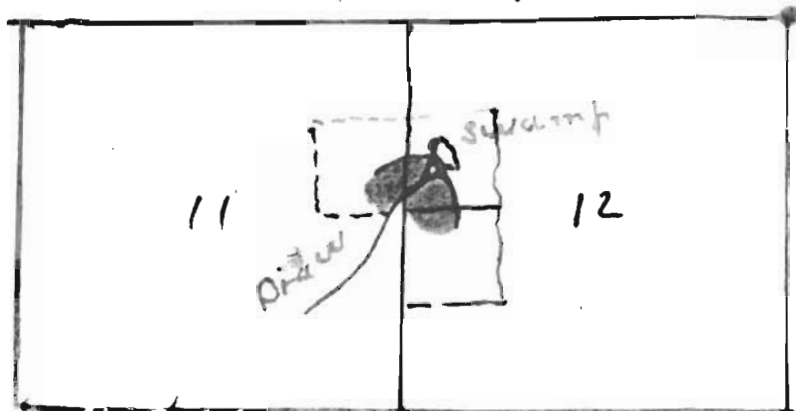

Application No. 11985

Permit No. 8887