


1 Irrigating Block 284-285

81811

SEC. 10
15

Tp. 2 N

R. 32 E

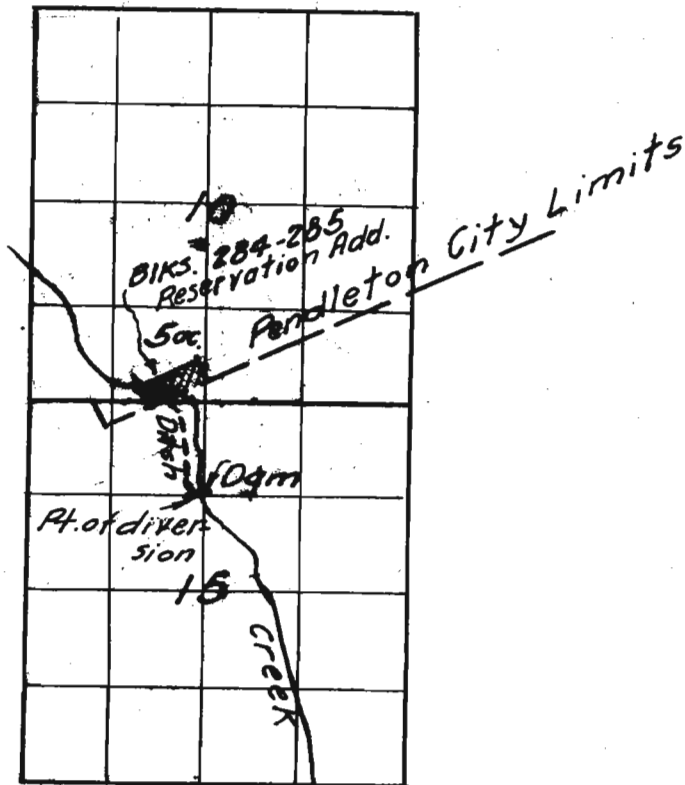

T. 2 N., R. 32 E.

you can leave
out Block 226
as we do not
irrigate it any way
yours

Application No.
Permit No.

11818
8372

Mary H. Parker