


—MAP—

Accompanying application of SOREN M. CHRISTENSEN of Gold Hill Jackson County, Oregon. for permit to the waters of Rogue River Jackson County Oregon, for irrigation purposes.

—March 1928.—

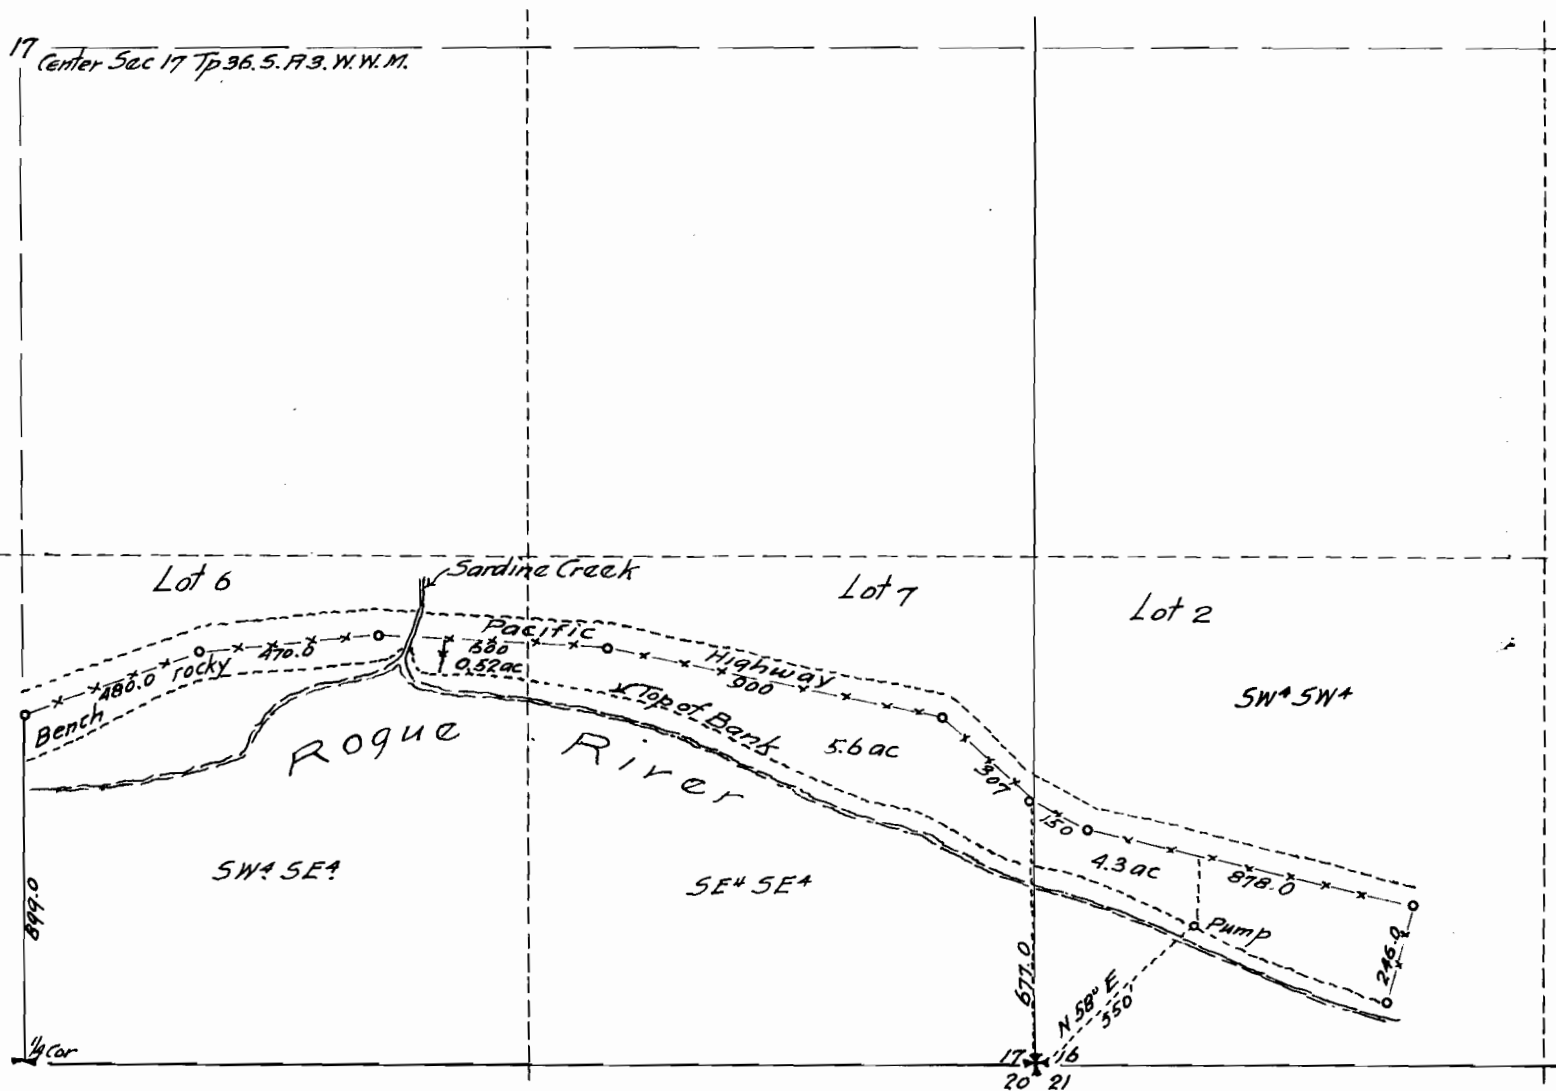

Map made from notes taken in the field in Survey made by C. Z. Boyden County surveyor. The same showing correctly Lands to be irrigated, together with streams and ditches in immediate vicinity.
Compiled by.


—Fred N. Cummings, C.E.—

Application No. 11485

Permit No. 8898

Accompanying application of Harry N. Cummings N. 51 N
 Gold Hill Jackson County Oregon, for permit to the water
 of Rogue River Jackson County Oregon, for irrigat
 purposes.

March 1928

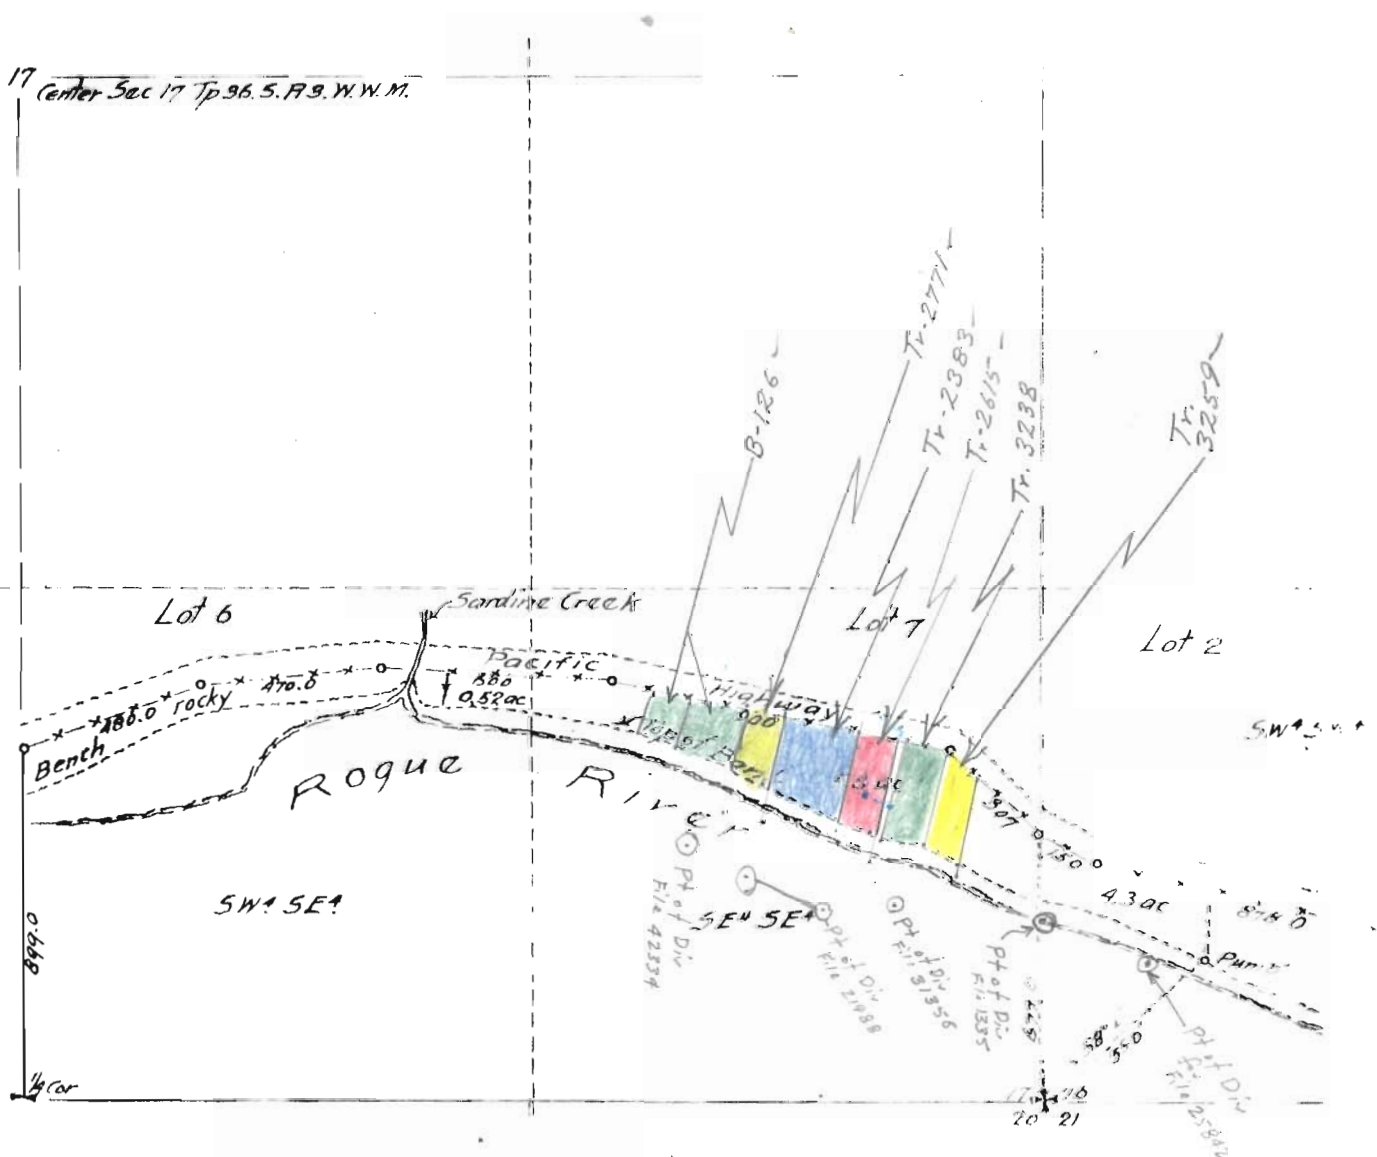

Map made from notes taken in the field in Survey
 made by C. Z. Boyden County Surveyor. The
 showing correctly Lands to be irrigated, together
 with streams and ditches in immediate vicinity
 Compiled by
 Fred N. Cummings. C. E.

Application No. 1 95

Permit No. 6016