


FRANK HEINEY

— MANUFACTURER OF —

MOULDING, ROUGH AND FINISHING LUMBER

GRESHAM, OREGON, _____ 190

Application No. 11404
Permit No. 8389

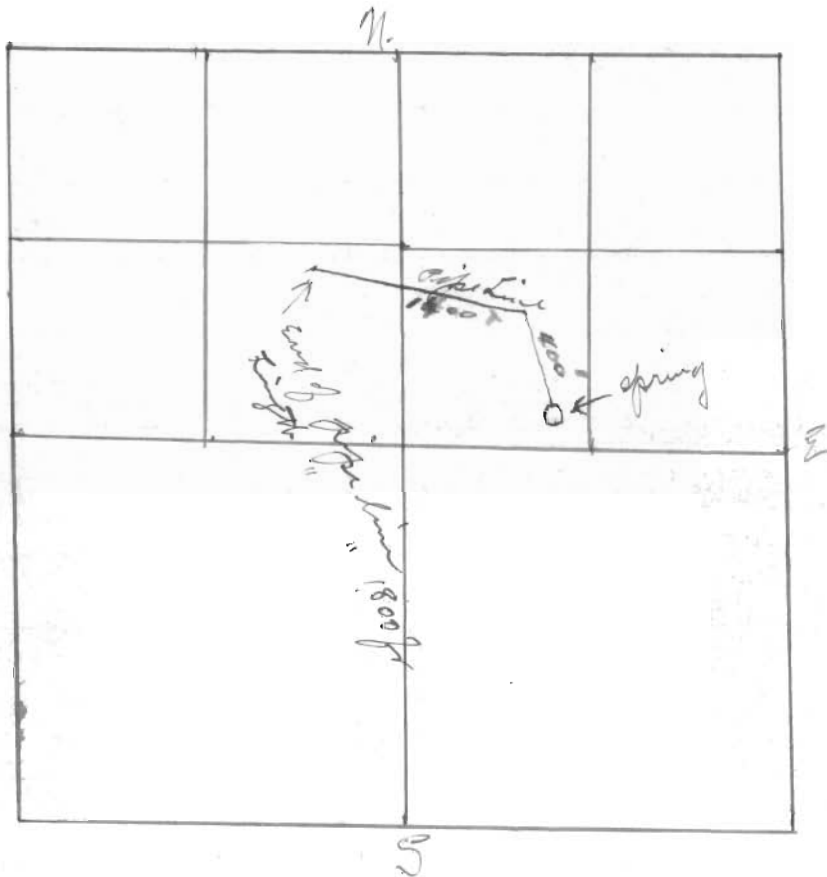

see 21-15.3 East

Malt Co Oregon

This pipe line was put in over 20 years ago. Has been in use ever since and is still in use over all the land on which the spring and pipe line is situated.

Frank Heiney
Hornah M Heiney
Richard Heiney

11404