


- Map -

Accompanying application of E. R. Reames of Talent, Jackson Co. Oregon. for permit to the waters of Wagner Cr. tributary to Bear Cr. Jackson Co. Oregon. for the purpose of a swimming tank

March 1928

Tp. 39S. R1W. WM.

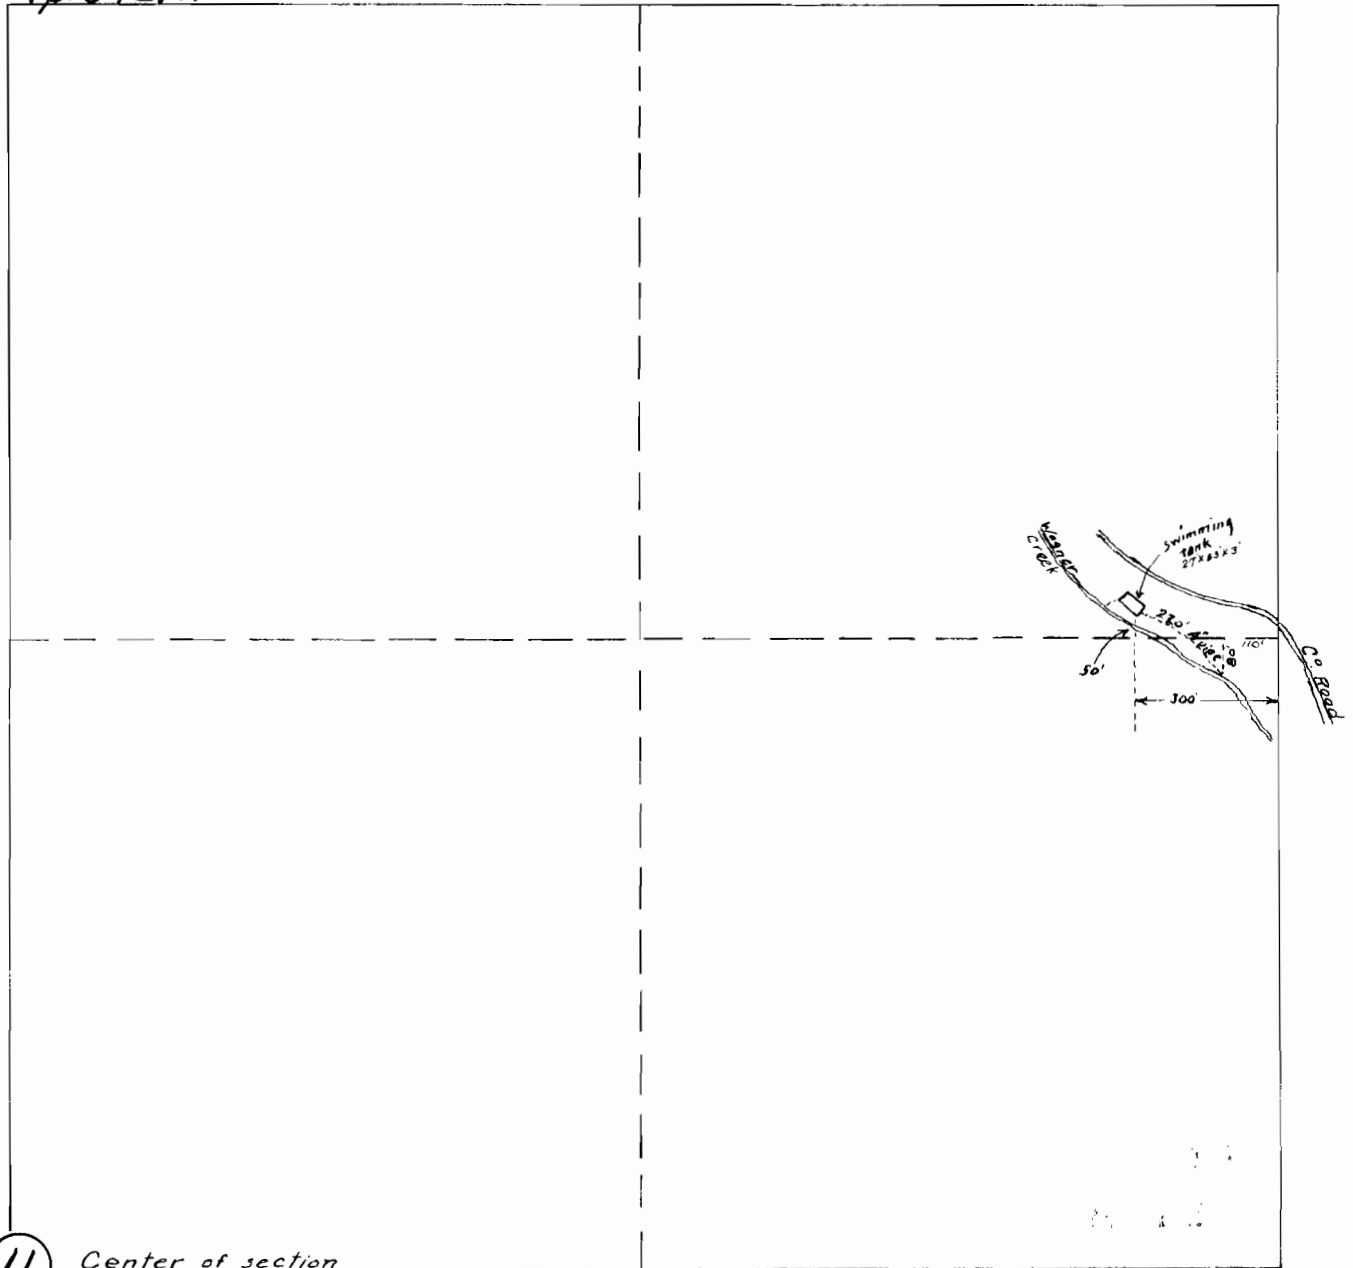

11

Center of section

Map made from measurements taken by W.M. Darby  
Correctly showing location of swimming tank, point of diversion together with streams and ditches in immediate vicinity,  
Compiled by W.M. Darby  
Ass't Water Master