

UNITED STATES DEPARTMENT OF AGRICULTURE
FOREST SERVICE

Permit: S 8429
Volume: 1A
Strm: RAND SPR
Trib: ROGUE R
Priority: 4/04/28

MAP SHEET


No. *Siskiyou National Forest*

Division _____ District _____, Block _____

T. 34S, R. 8W, W M., Section 24, Quarter SW¹NE¹NE¹SE¹

Mapped by *J.P. Dewitt, For. Ran.*, Traced by *A.G.J.*

Scale: 16 inches = 1 mile.

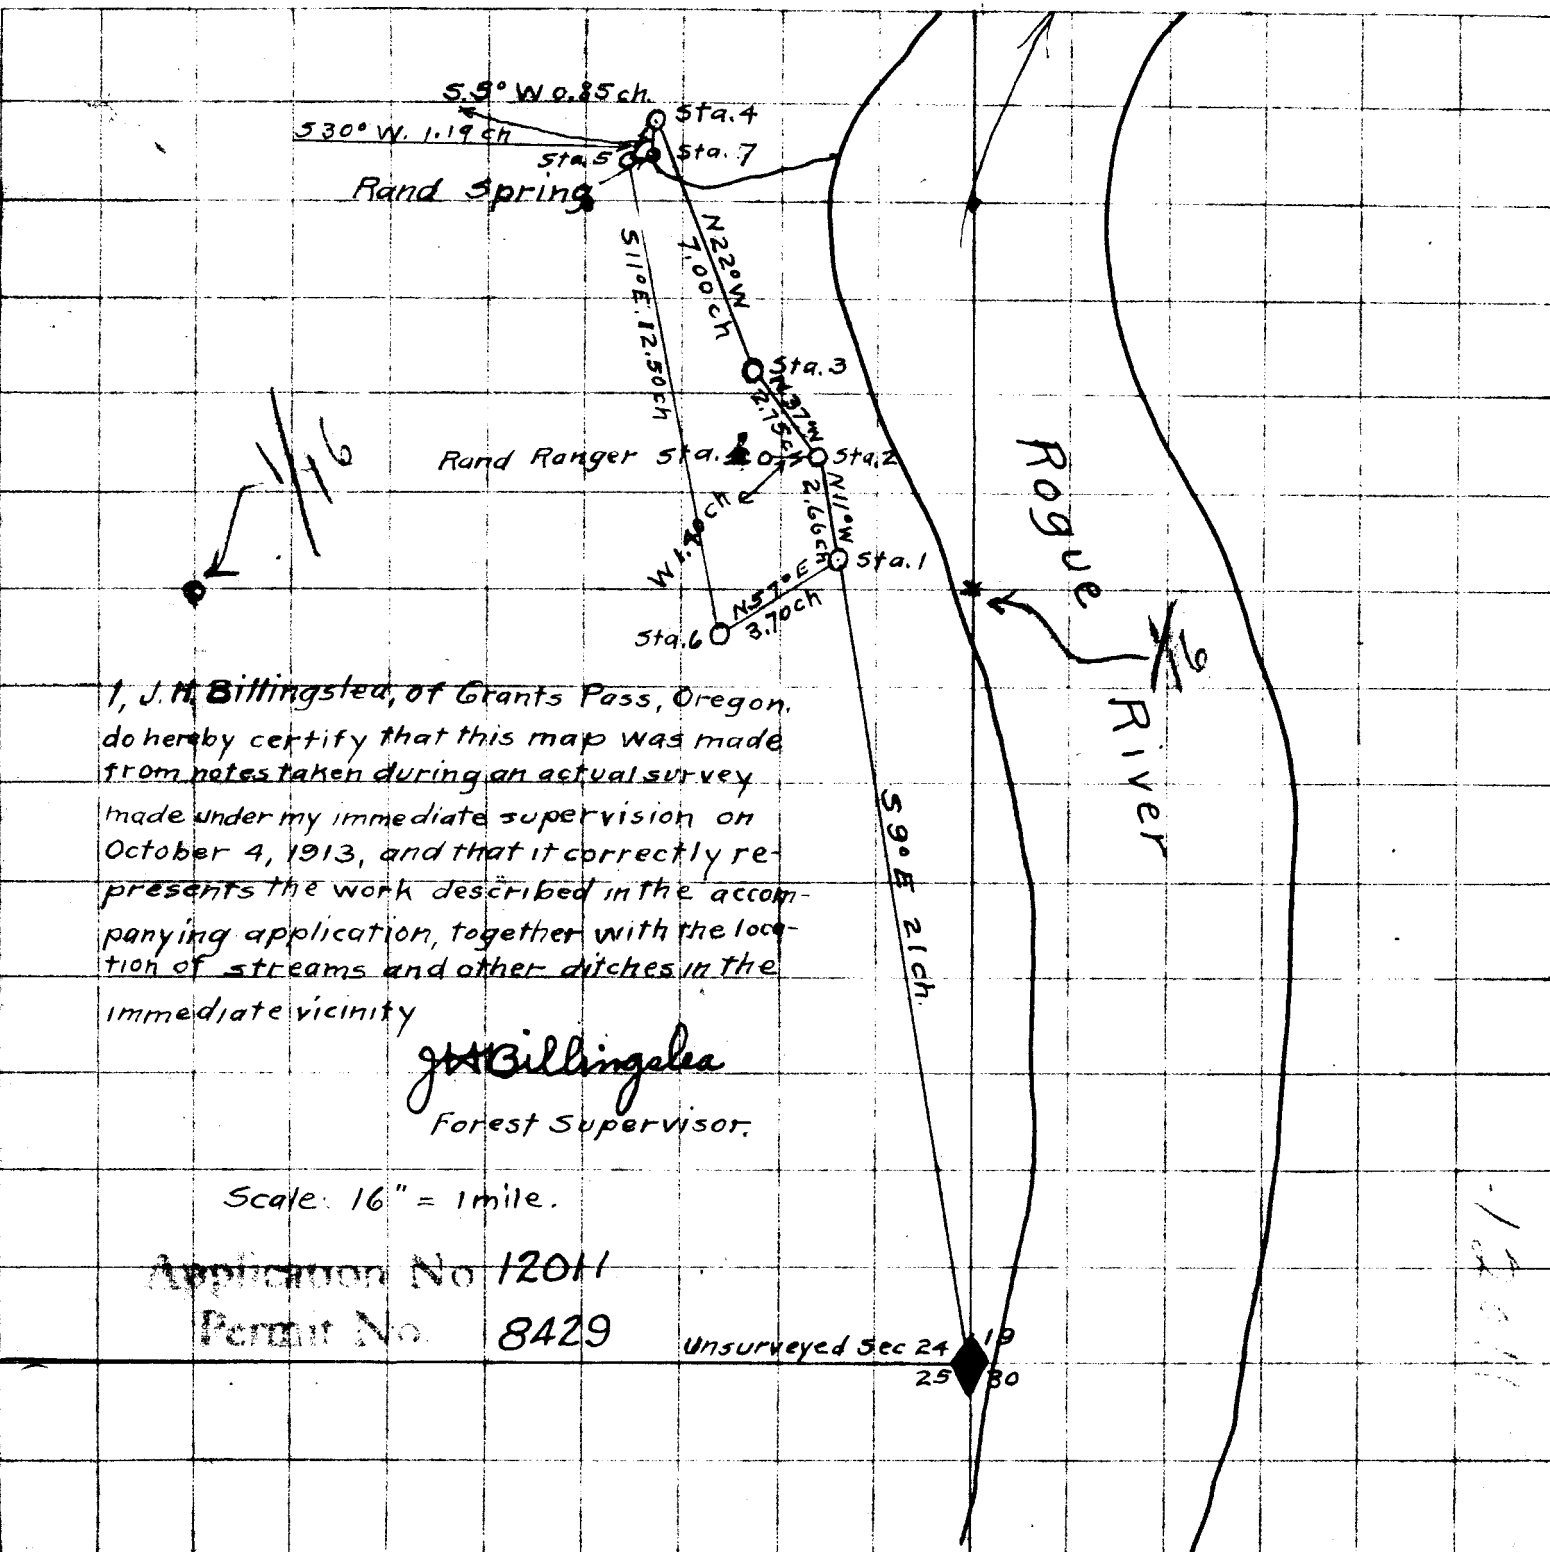

I, **J. H. Billingslea**, of Grants Pass, Oregon, do hereby certify that this map was made from notes taken during an actual survey made under my immediate supervision on October 4, 1913, and that it correctly represents the work described in the accompanying application, together with the location of streams and other ditches in the immediate vicinity

J. H. Billingslea
Forest Supervisor.

Scale: 16" = 1 mile.

Application No 12011

Permit No. 8429

Unsurveyed Sec 24 19 25 30

12011