

# SECTION 4

T 1 S R 1 E W. M.

1" = 100'

N

AMENDED MAP ACCOMPANYING AMENDED APPLICATION OF A. L. VEAZIE TO APPROPRIATE WATERS OF SMALL SPRINGS SITUATED ON LOT 4, 6 & 7, BLOCK 2, SEVENTH STREET TERRACES, PORTLAND, OREGON.

(Lands to be irrigated are enclosed by hatching).

Springs covered by said application are the following:  
(1) Caruthers Spring, located in the SW corner of Lot 6 Block 2; (2) Barrett Spring, being located in or near the SW corner of said Lot 7 Block 2, or in the street immediately west thereof; (3) an unnamed spring arising near the south line of said Lot 4; and all other springs located on said Lots 6 and 7.

SEVENTH ST  
TERRACES

SHEFFIELD AVE.



HOFMANN AVE.

PIPE A

PIPE B

PIPE C

SECTION 4

T I S R I E W . M .


1" = 100'



FINAL PROOF ON  
MAP ACCOMPANYING/APPLICATION OF  
A. L. VEAZIE TO APPROPRIATE WATERS  
OF SMALL SPRINGS SITUATED ON LOT  
6, BLOCK 2, SEVENTH STREET TER-  
RACES, PORTLAND, OREGON.

(Lands ~~not~~ irrigated are en-  
closed by hatching.)

SEVENTH - ST.  
TERRACES

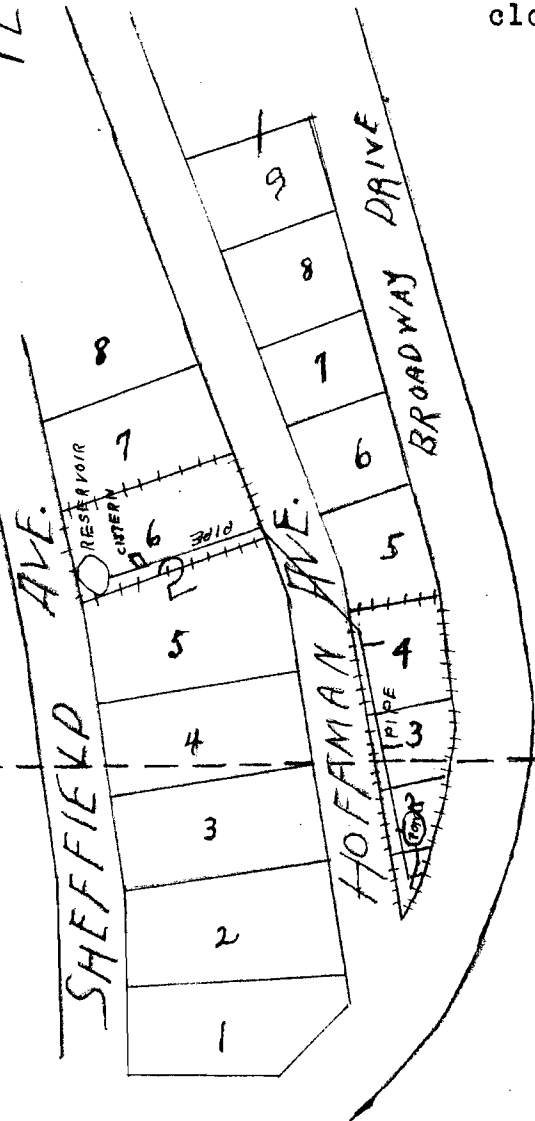

4

3

9

10

Application No. 12044  
Permit No. 8448