


Length of Pipeline from the house to spring 300 feet.

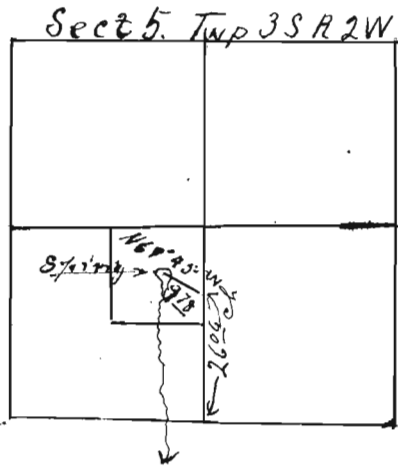

Thomas Herd Jr  
Newberg Oregon.

Application No. 12005  
Permit No. 8463

S