

Detail of Irrigation System
 Property of
 Mrs. Edith M. Bell Hill
 Sec. 21 T2N R7E WM
 Doty and Doerner
 Landscape Contractors
 Scale 1" = 20' July 1929



- Legend
- Valve
 - ⊙ Hydrant
 - ⊗ Revolving Sprinkler
 - S+W Stop and Waste
 - Dr Drain

Highway

Reservoir

House service

Pool

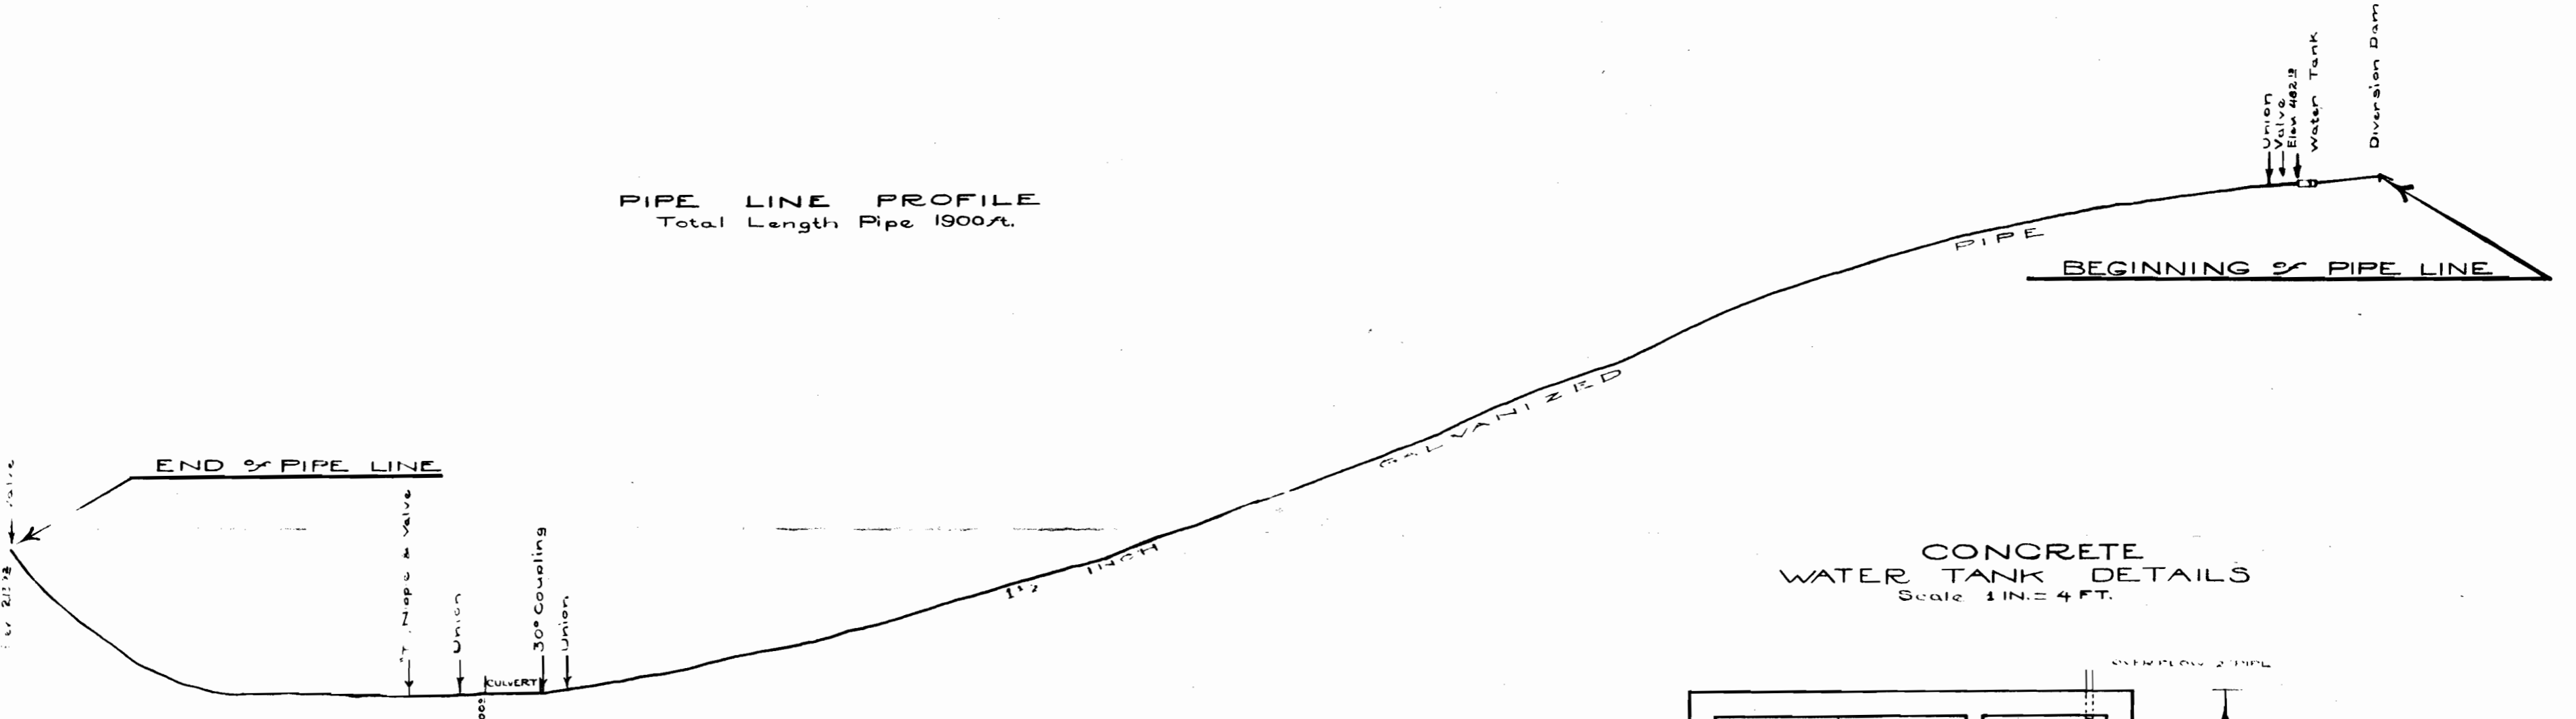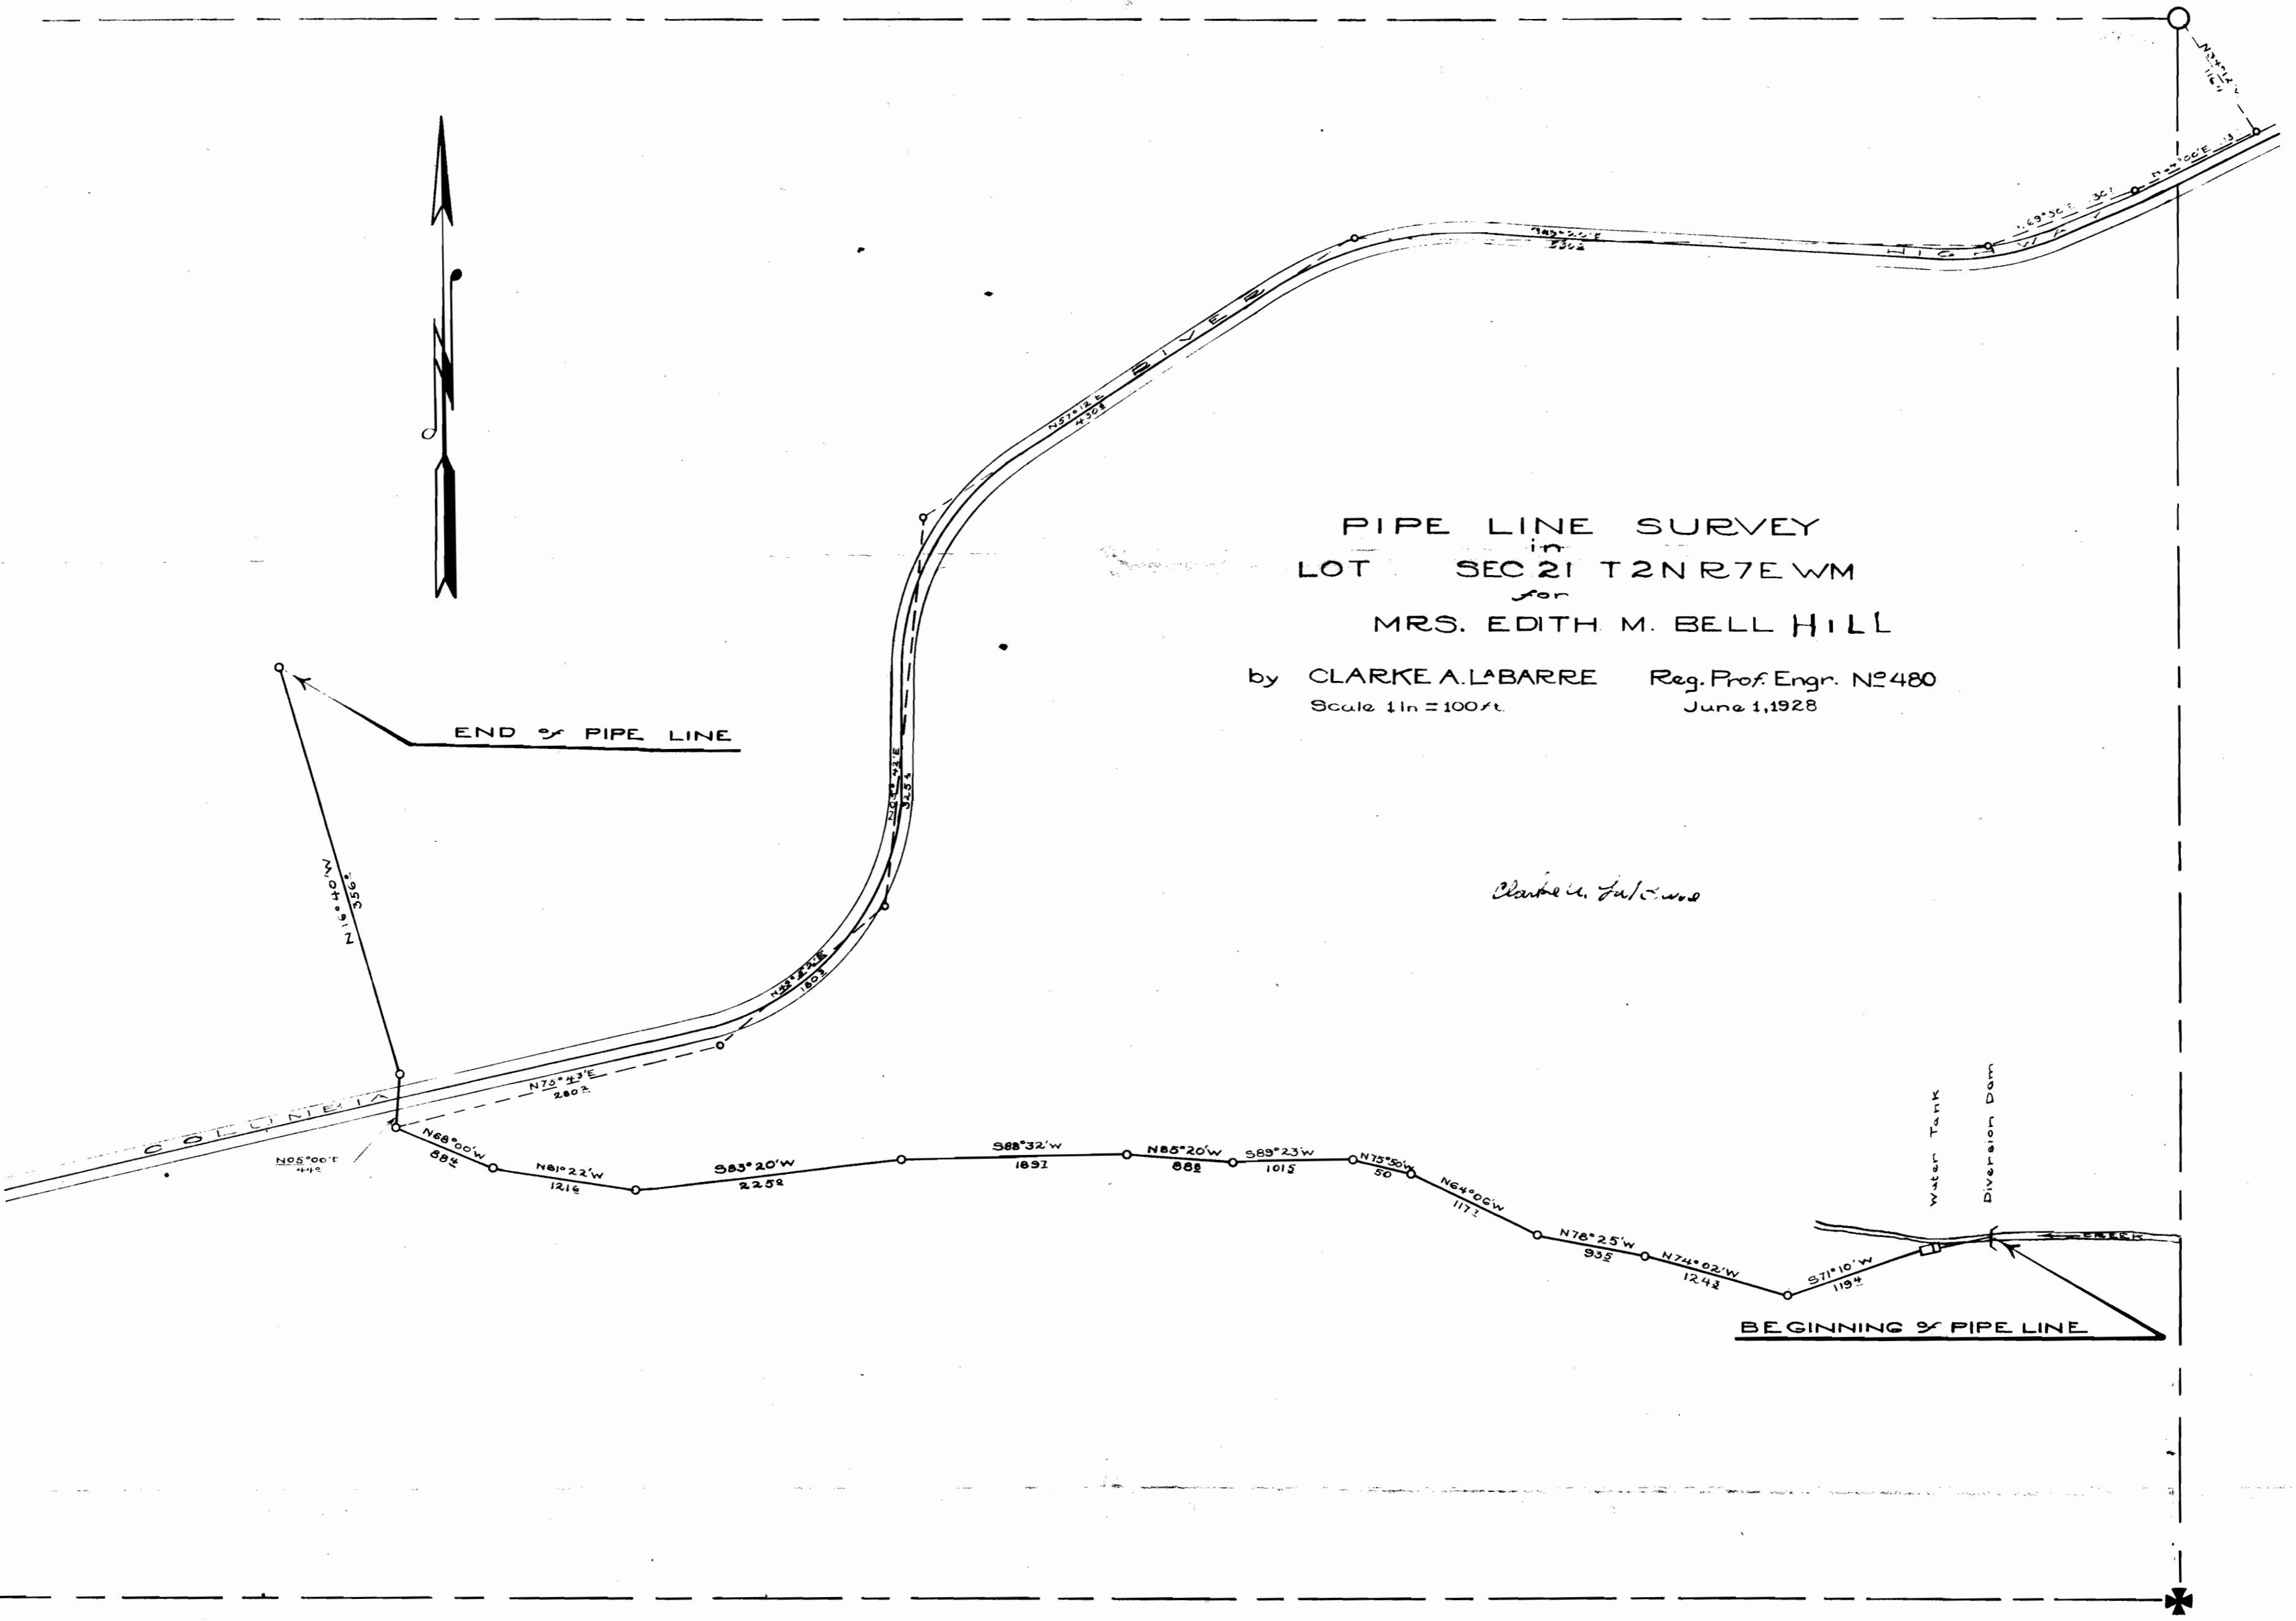

CONCRETE WATER TANK DETAILS
Scale 1 in = 4 ft.

