

Application No. 1708  
Permit No. 848

MAP - Showing Location of  
Pacific Railway and Navigation Company's  
PIPE LINE for TANK SUPPLY  
in S.E. 1/4 Section 26 T.3.N.R.7.W. W.M.  
Scale 400 ft = 1 inch.

SURVEYOR'S CERTIFICATE

I, E. E. Mayo of Portland, Oregon do hereby certify that this map was made from notes taken during an actual survey made by me on August 18, 1911, and that it correctly represents the works described in the accompanying application.


E. E. Mayo  
Surveyor

Center  
26

E. 1/4 Cor.

N.W. 1/4 of S.E. 1/4 Sec. 26

N.E. 1/4 of S.E. 1/4 Sec. 26

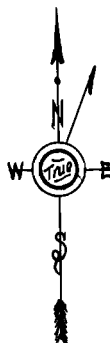

S.W. 1/4 of S.E. 1/4 Sec. 26

S.E. 1/4 of S.E. 1/4 Sec. 26

Intake of Pipe Line  
877.4' N. & 682.9' W.  
of S.E. Cor. Sec. 26  
T.3.N.R.7.W. W.M.

S. 1/4 Cor.

Sec. 26 Sec. 25  
Sec. 35 Sec. 36

