

12088


Sec. 33

34

Tp. 25

R. 1E.

Application of E.J. Frohman
of 166 St. Clair St., Portland

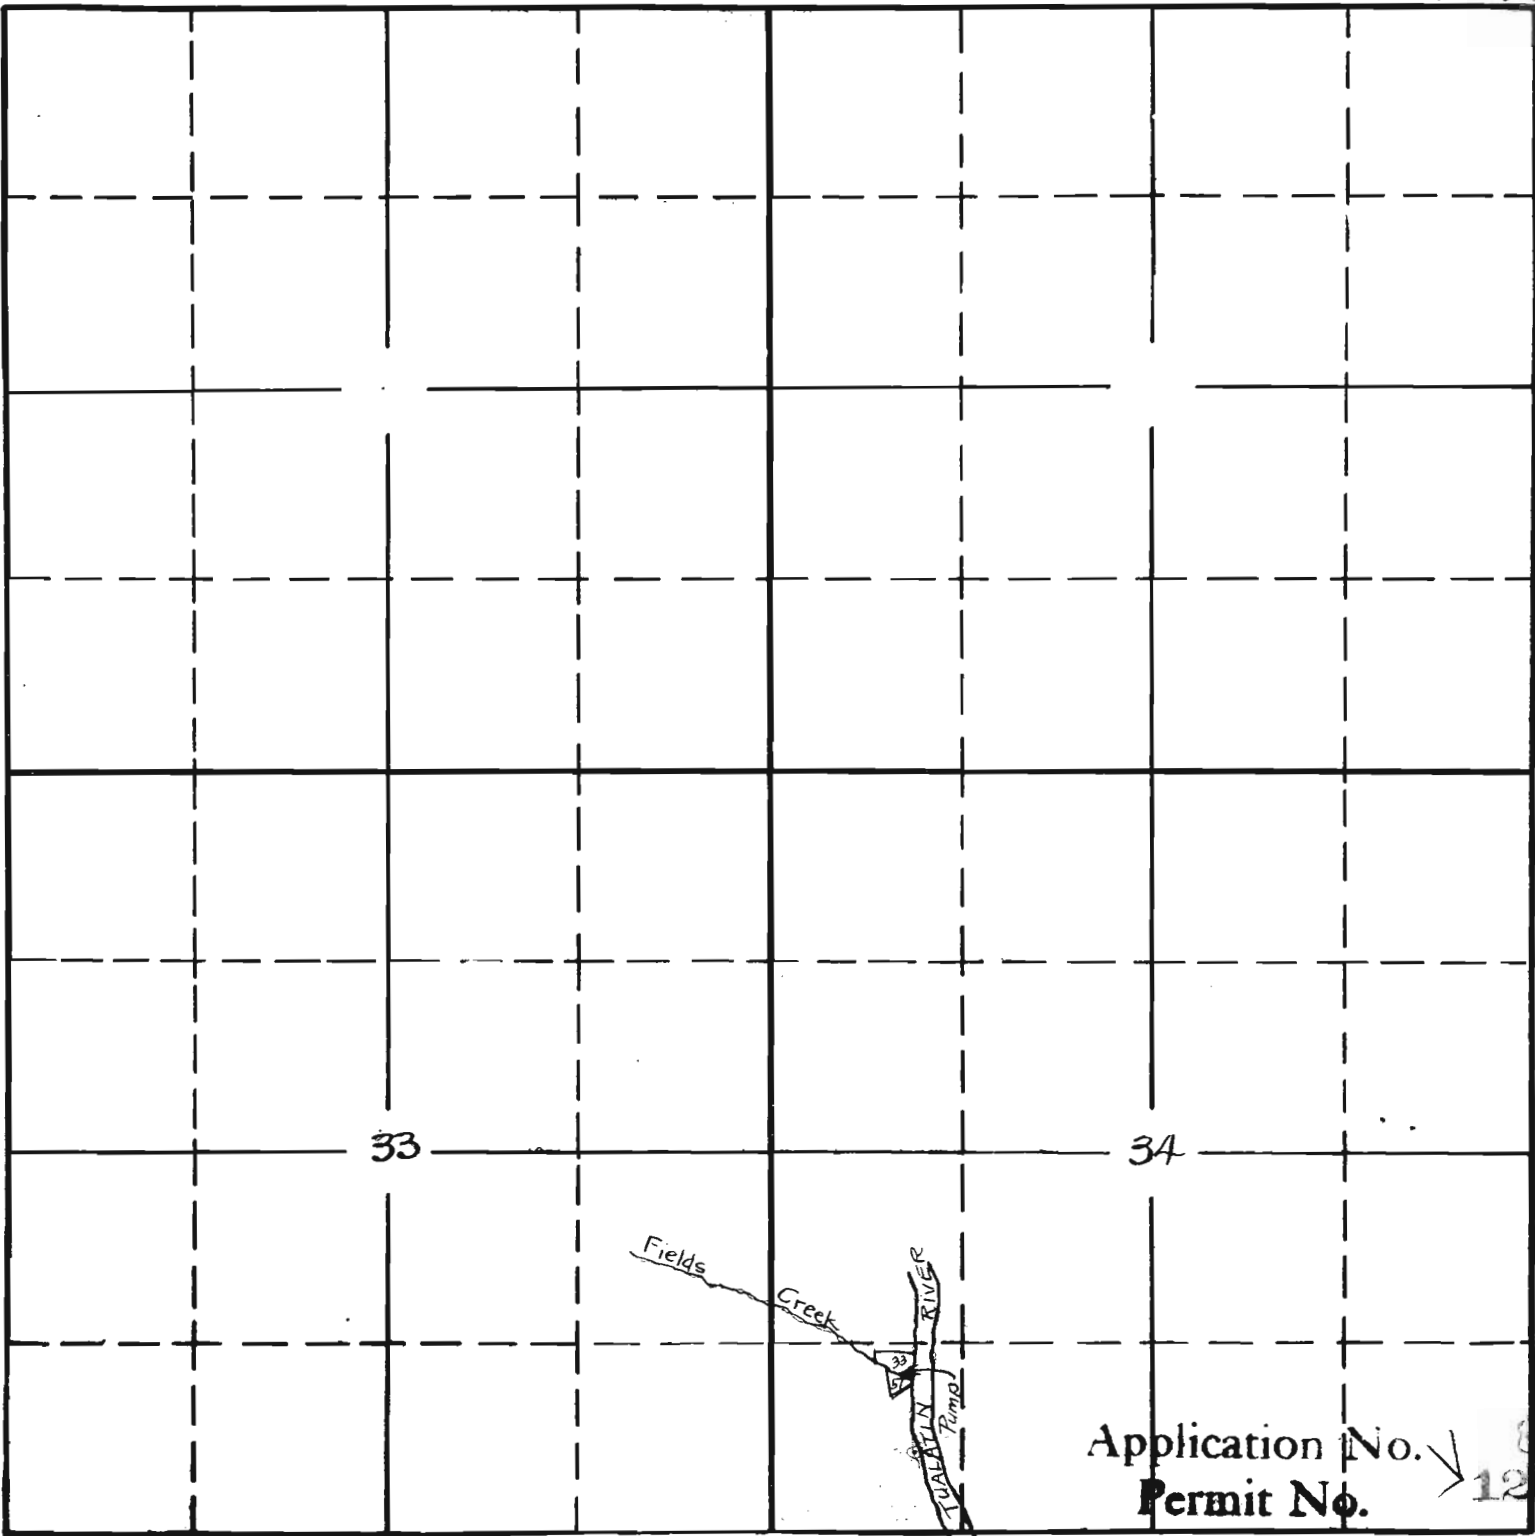

Application No. 8495
 Permit No. 12088