


11665

Sec. 15

Tp. 1 S

R. 3 W

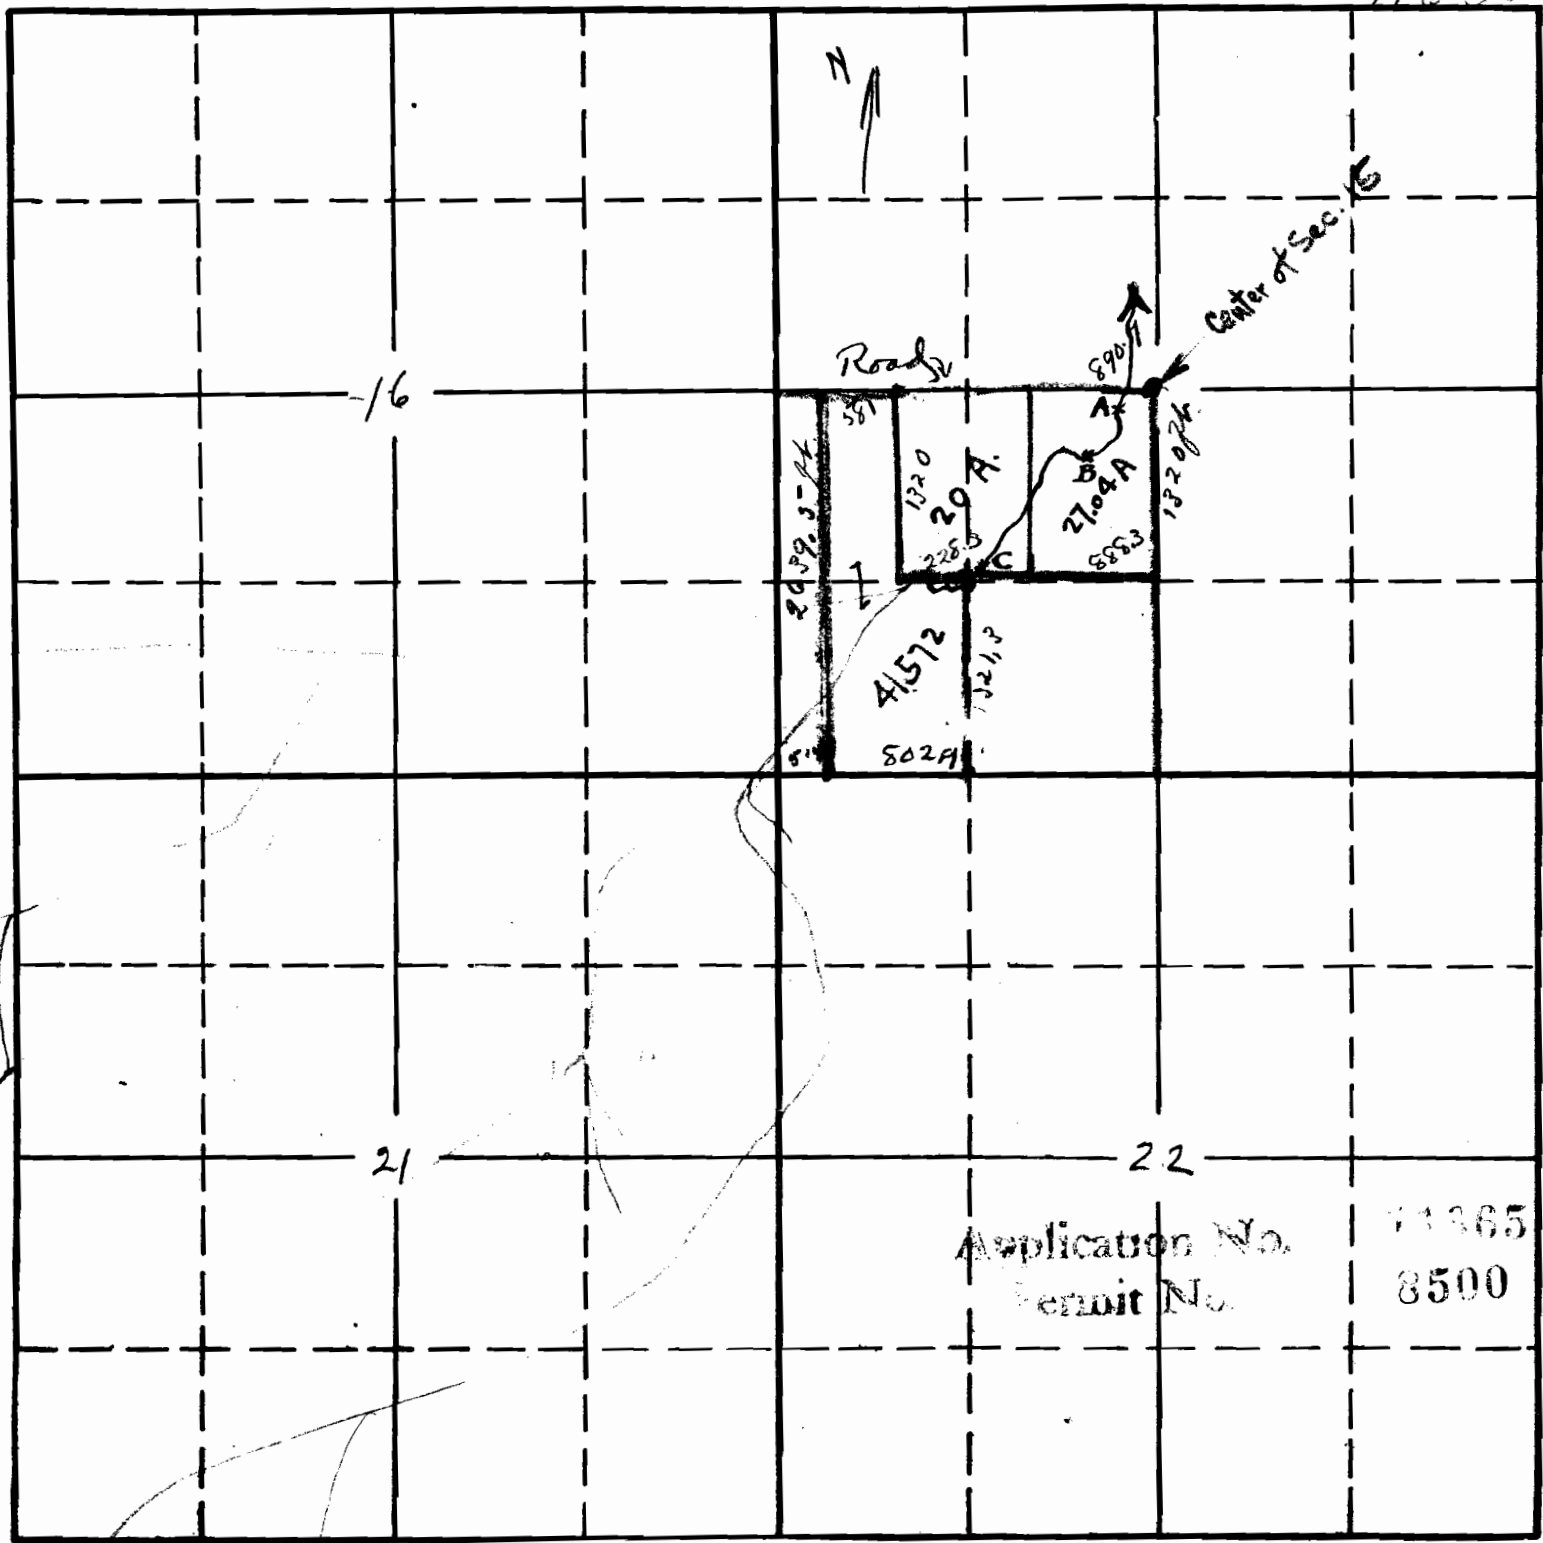

Application No.	71365
Permit No.	8500