


SECTION

26

TOWNSHIP 2, RANGE 3, W. M.

North

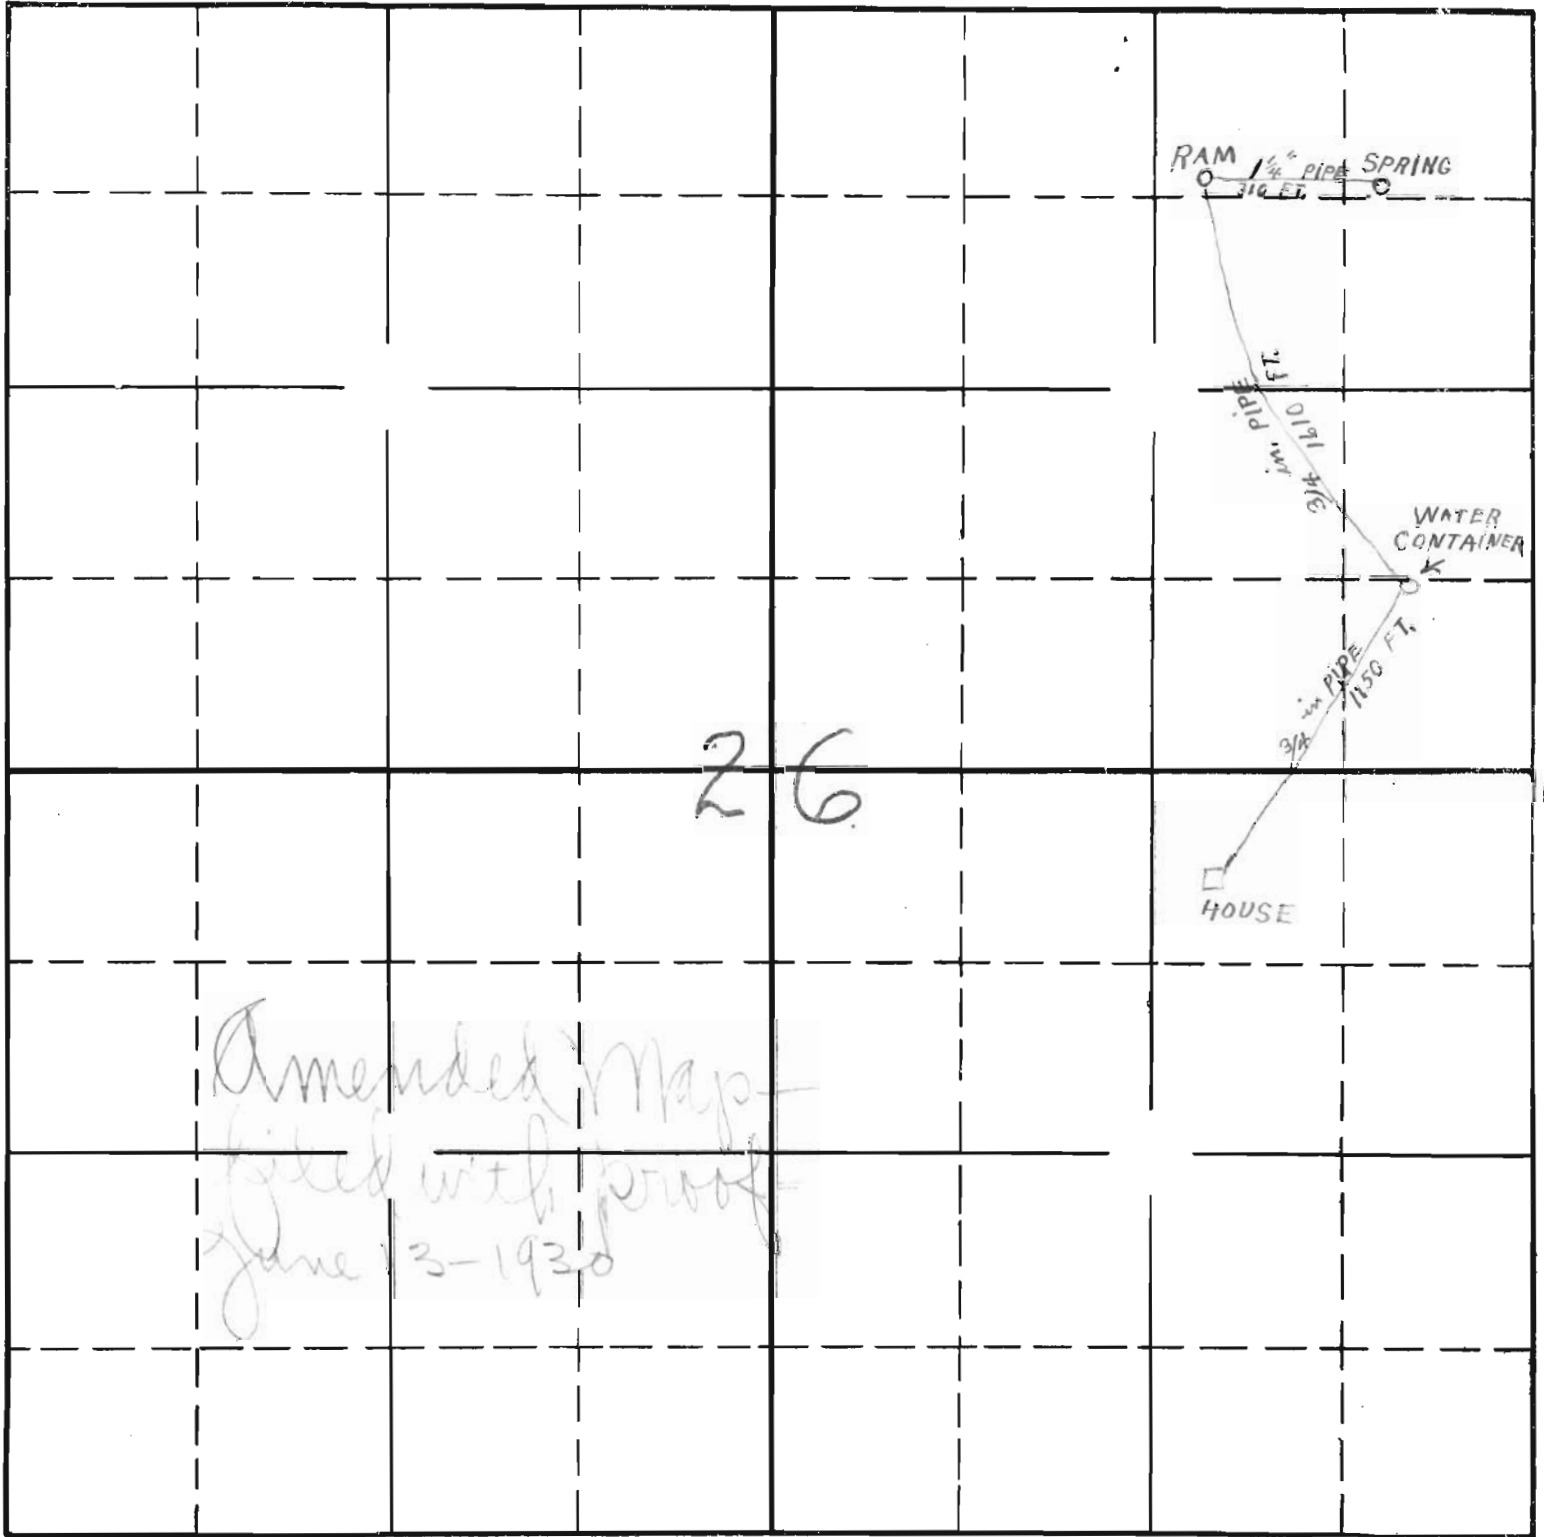

26

*Amended Map
filed with proof
June 13-1930*

South

APPLICATION No. 12103

PERMIT No. 8510

12103

Sec. 26

Lot 1
Spring
Kam

Tp. 2 S

R. 3 W.

1" Pipe

26

House

Application of Mervin Whitmore.

Application No.
Permit No.

12103
8510