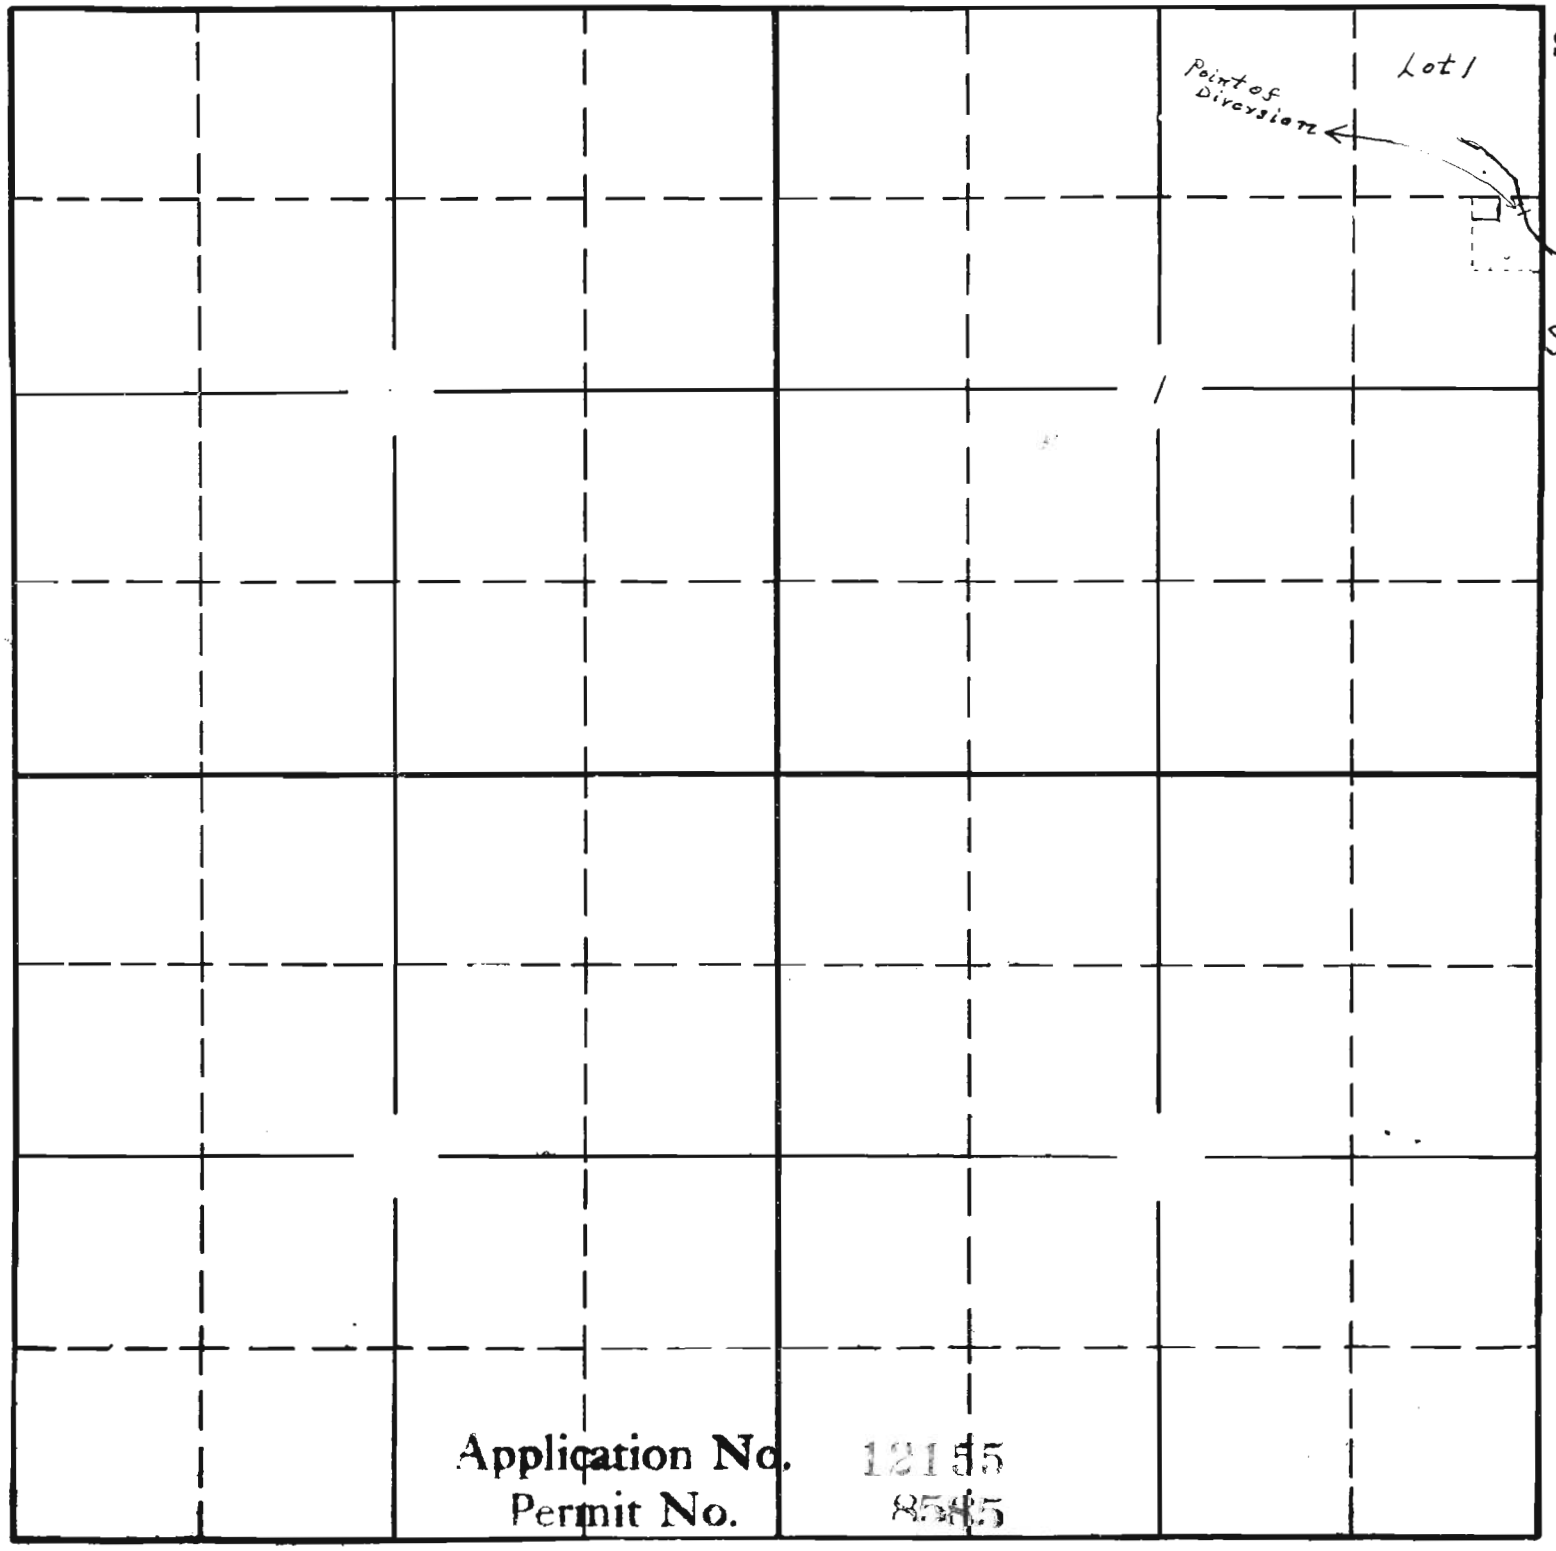
Point of Diversion
Lot 1
Sec. 1
Tp. 37
S.R. 15W.
Application No. 12155
Permit No. 8585