


SEC. 26 T. 6 N. R. 35 E.

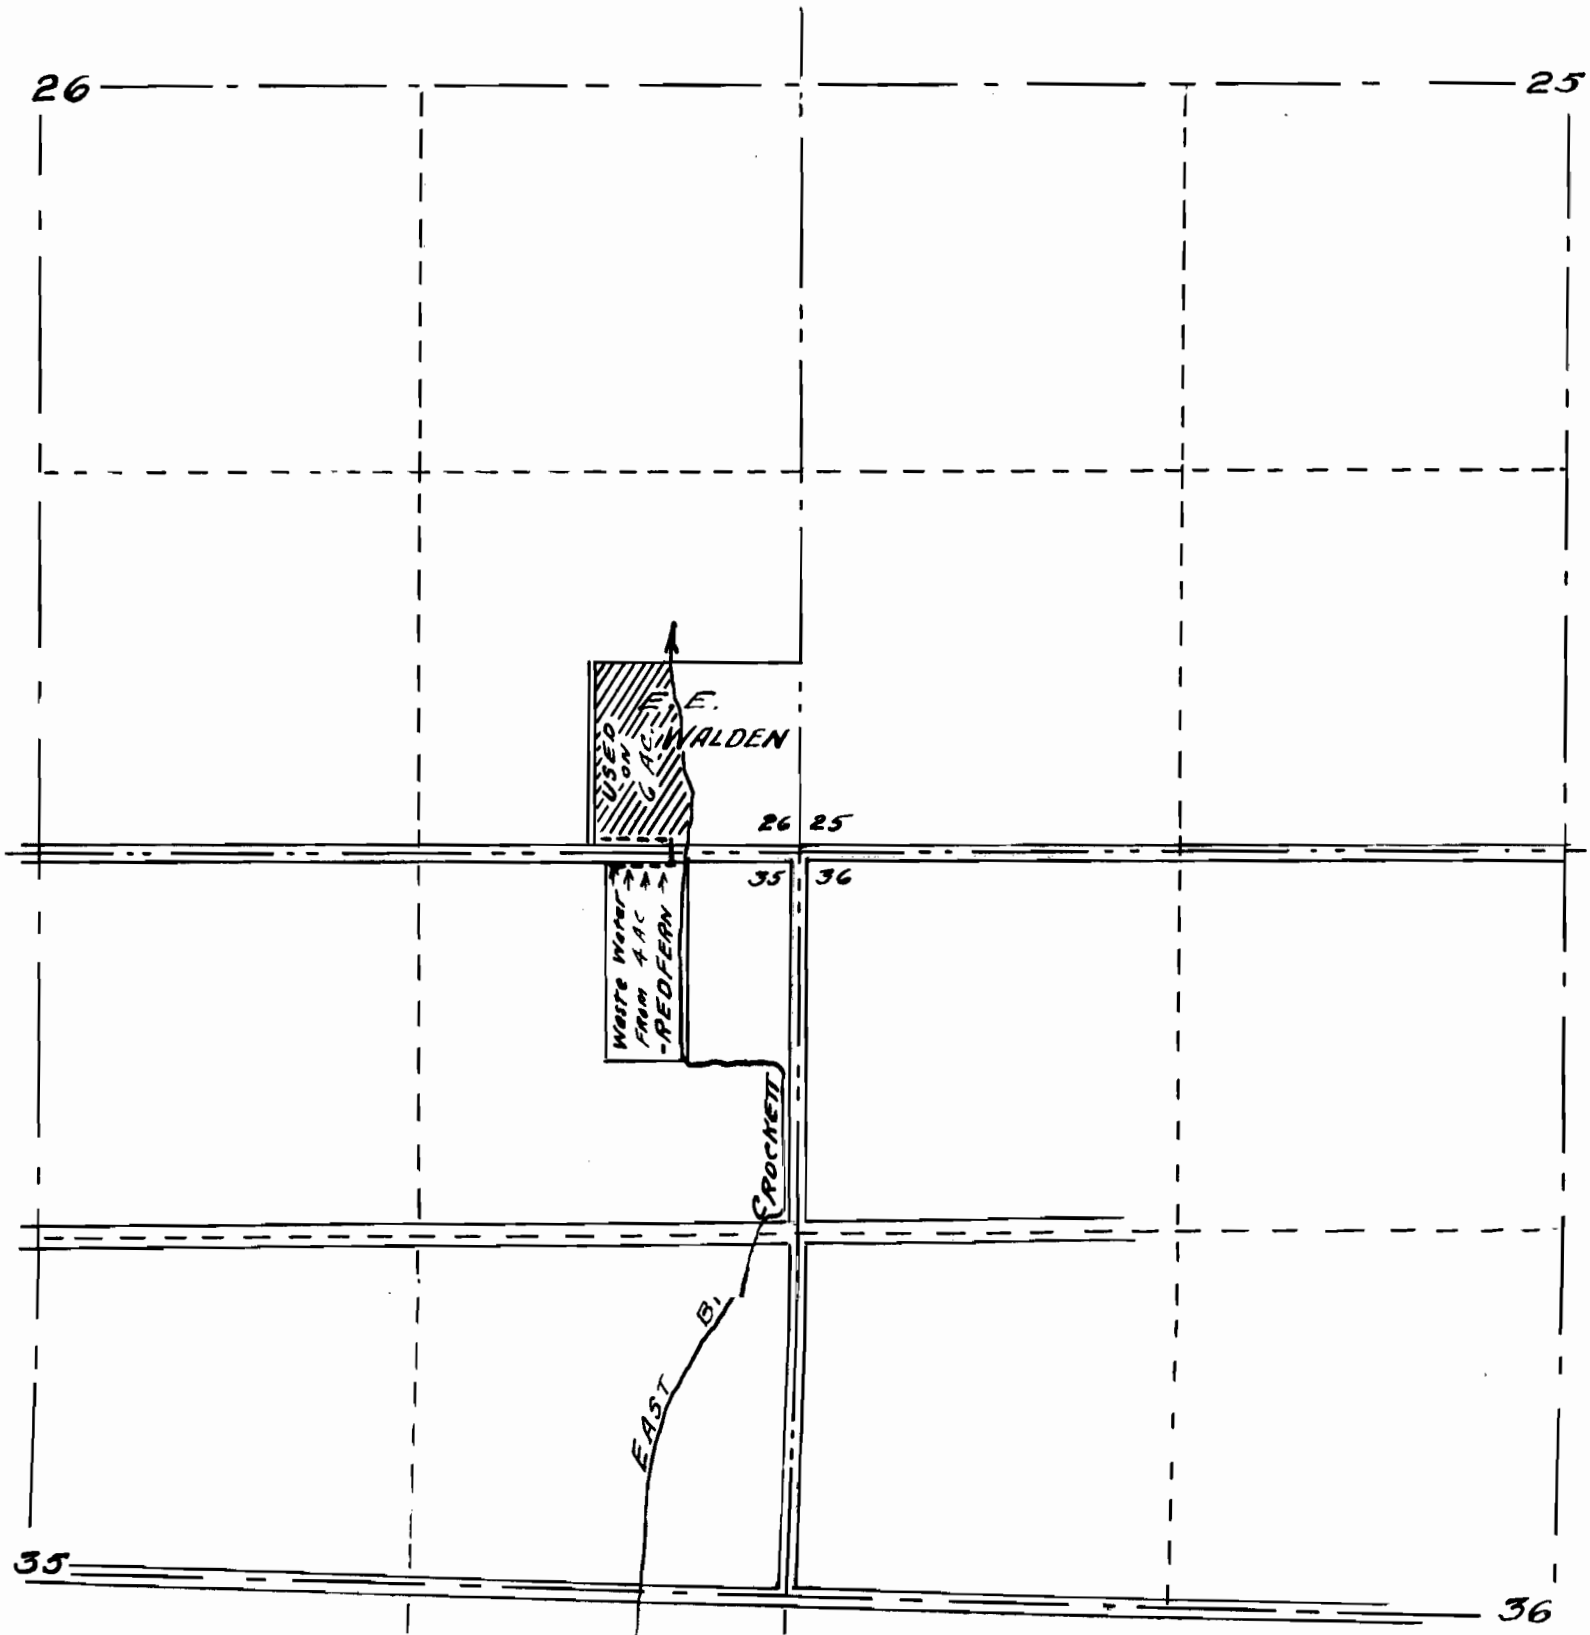


Map to accompany final Proof
App. 12242 Permit 8598

MAP

to accompany
Application
of

E.E. Walden

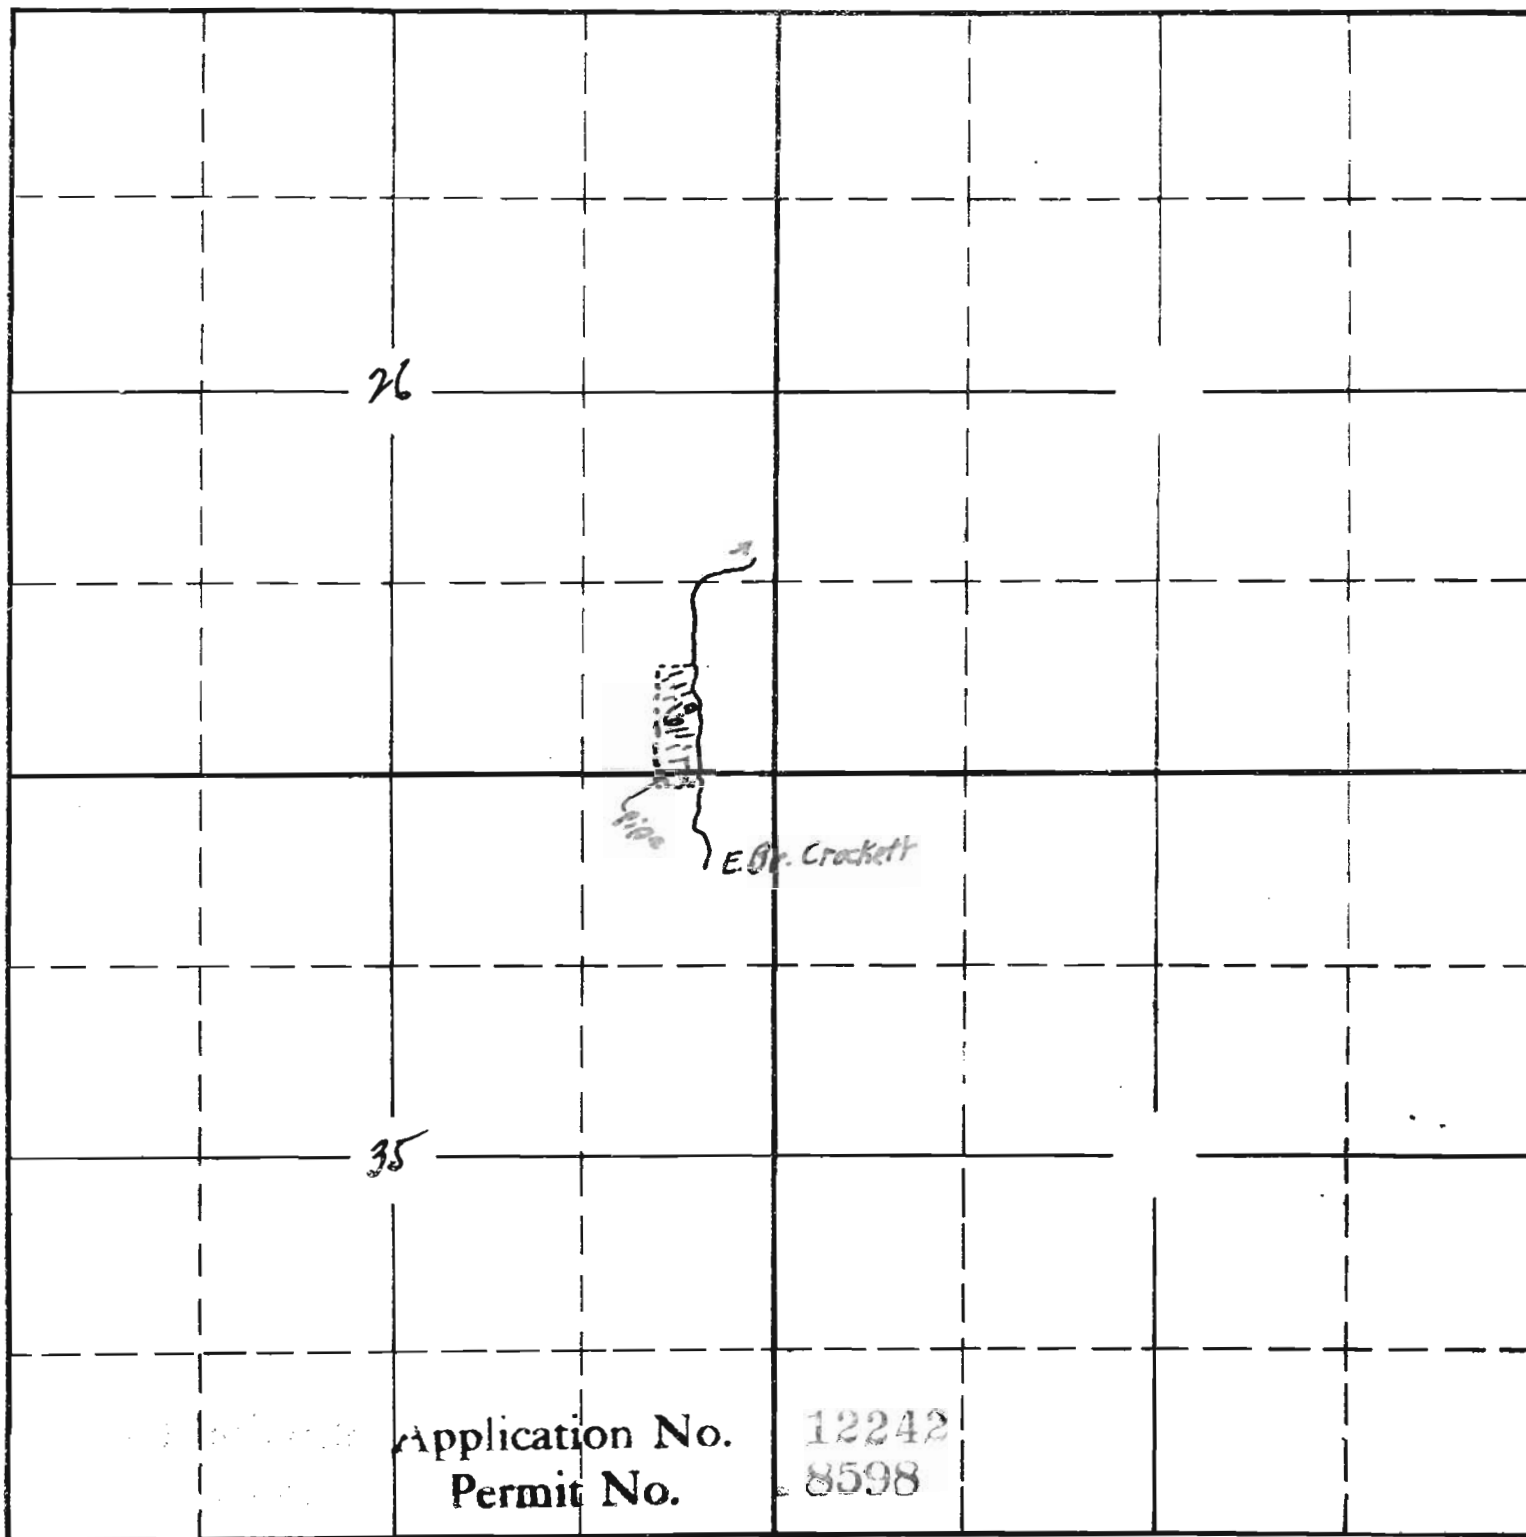

Sec. _____

Tr. 6 N.

R. 35 E.