Sec. 9

Tp. 9 S

R. 1 E

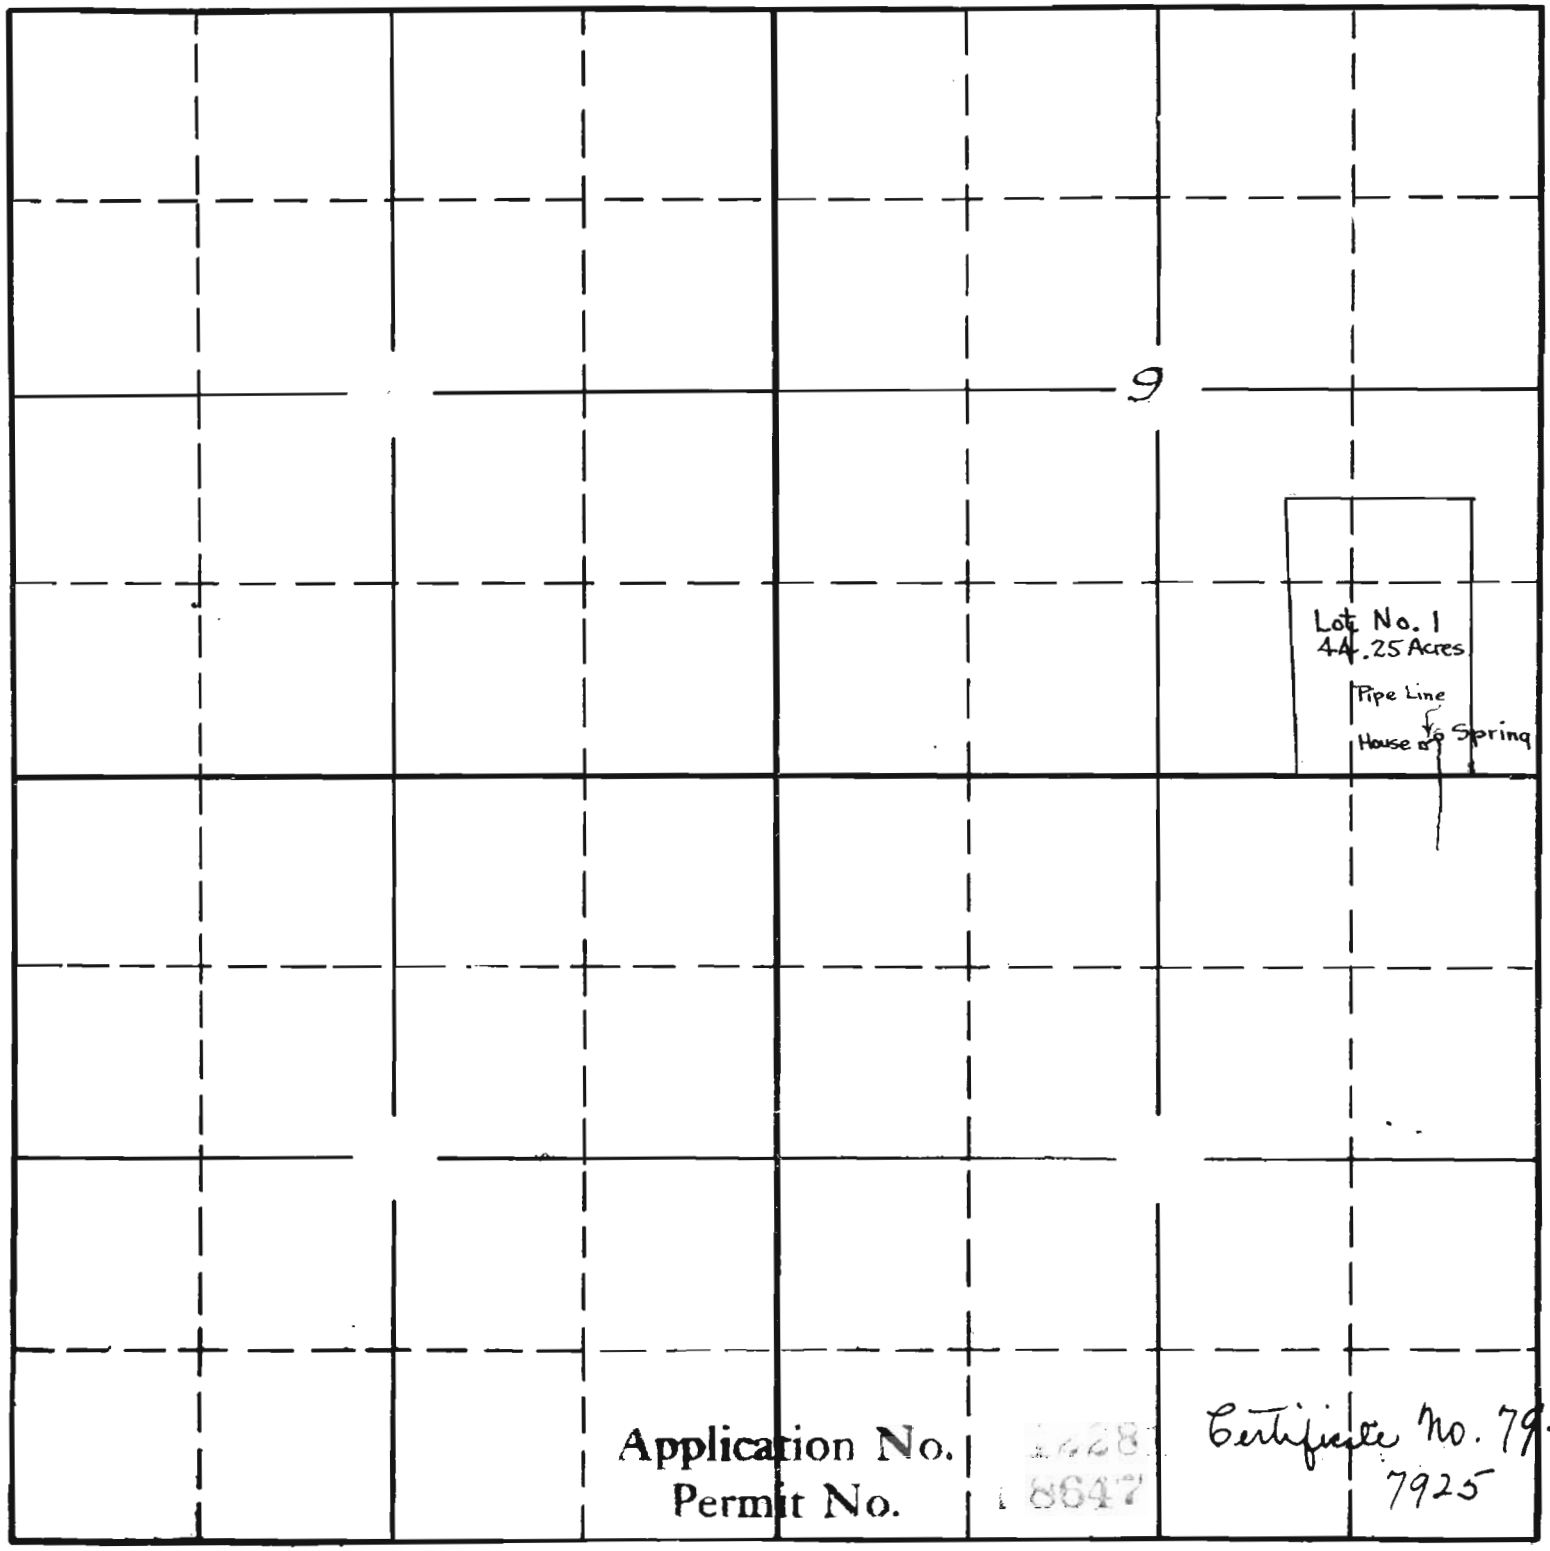

Application No. 6628

Permit No. 8647

Certificate No. 7925

7925