


Sec. 25

Tp. 5 S

R. 4 W

26

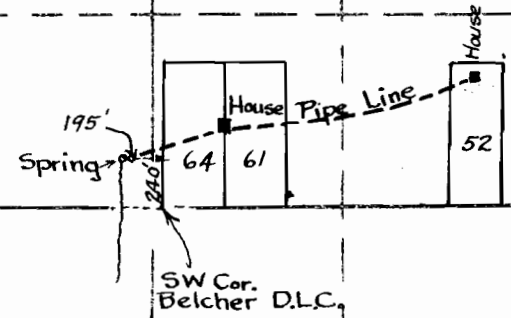

35

36

Application No. 20297
Permit No. 8830