

SECTION 5

26-27


34+35

TOWNSHIP 4 S, RANGE 11, W. M.

North

West

East

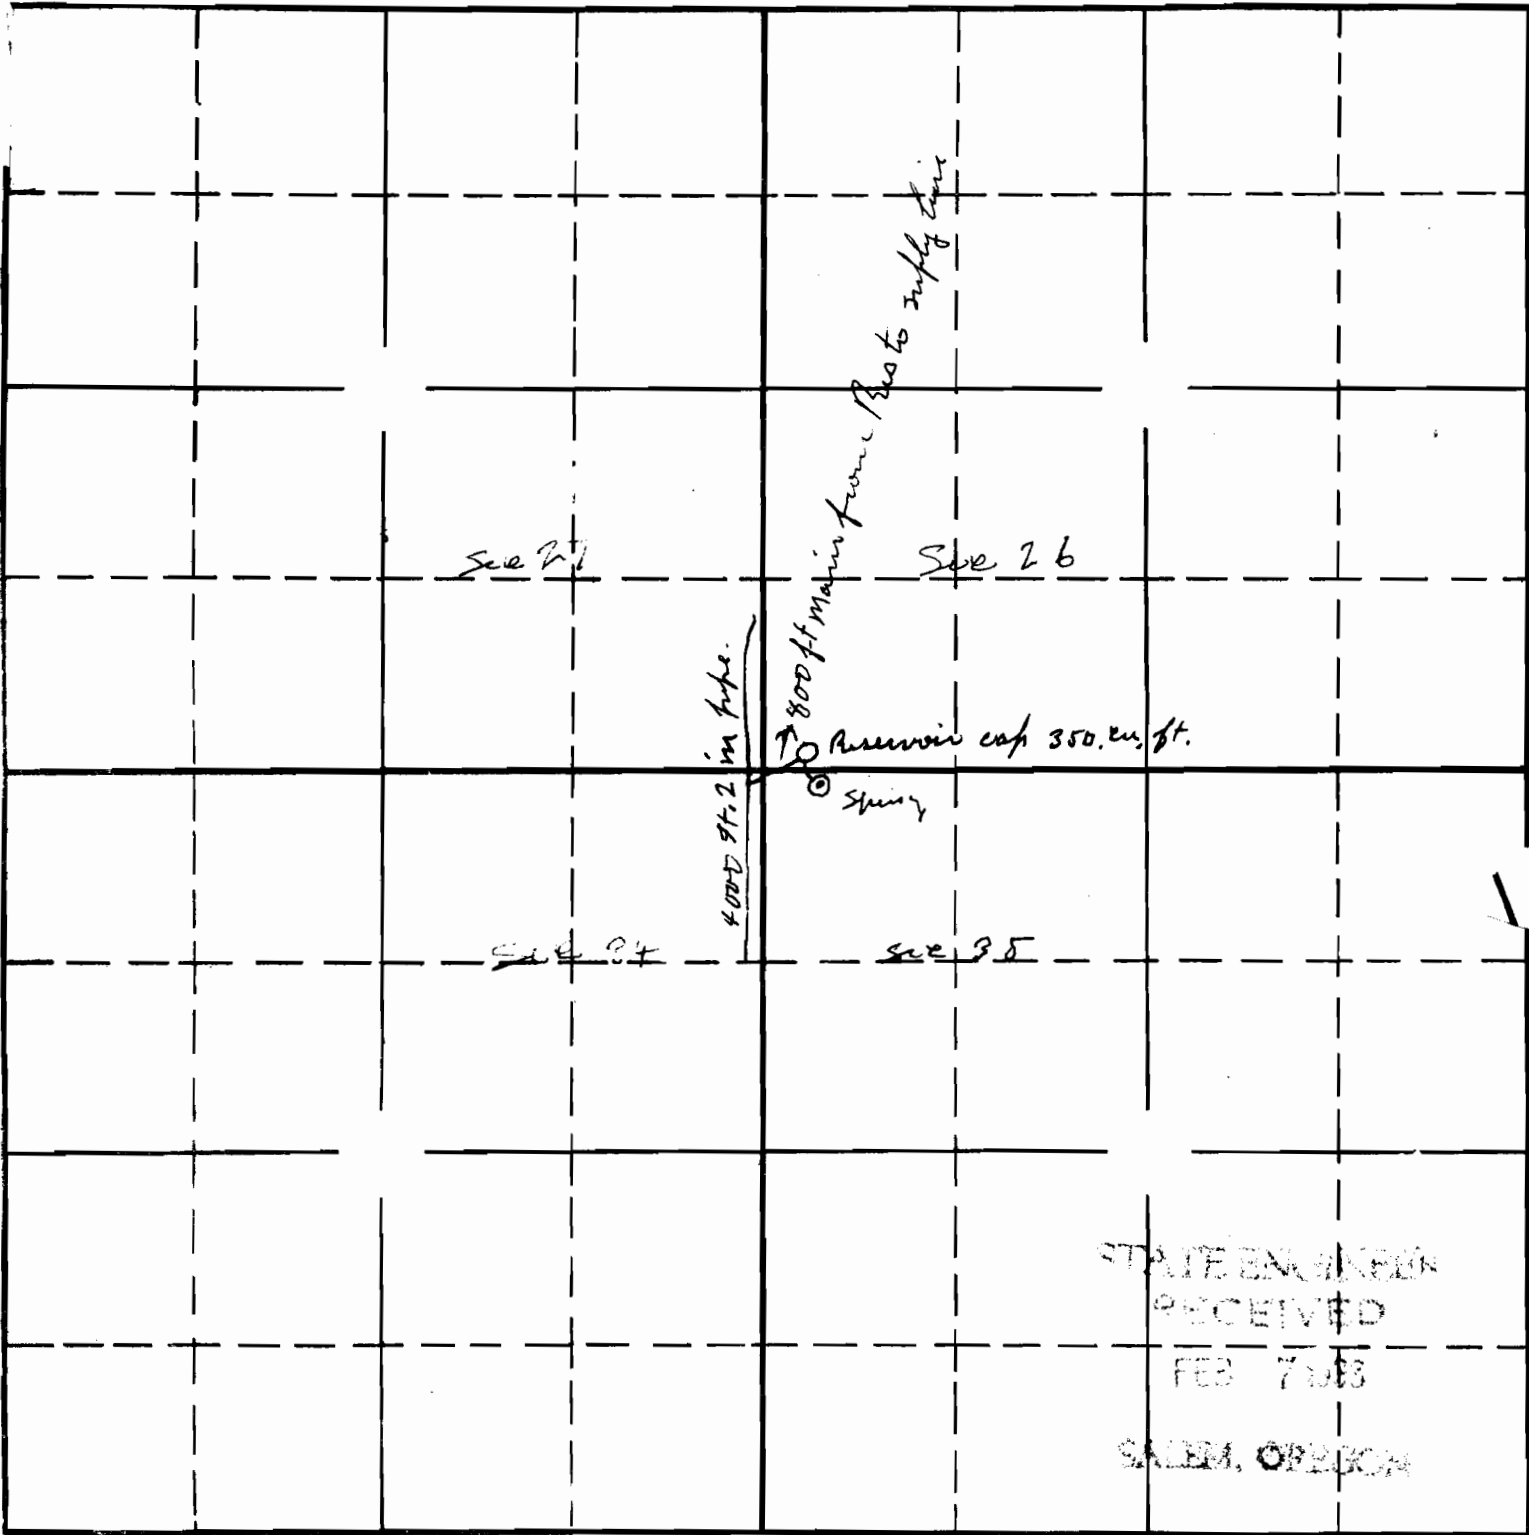

STATE ENGINEER
 RECEIVED
 FEB 7 1938
 SALEM, OREGON

South

Above complete water system
 now supplying water for 19 houses and
 one apartment house

APPLICATION No. 12327
 PERMIT No. 8688

D. HENRICKS.
 OCEAN LAKE DRE