


7.22SR & u. u.m

N

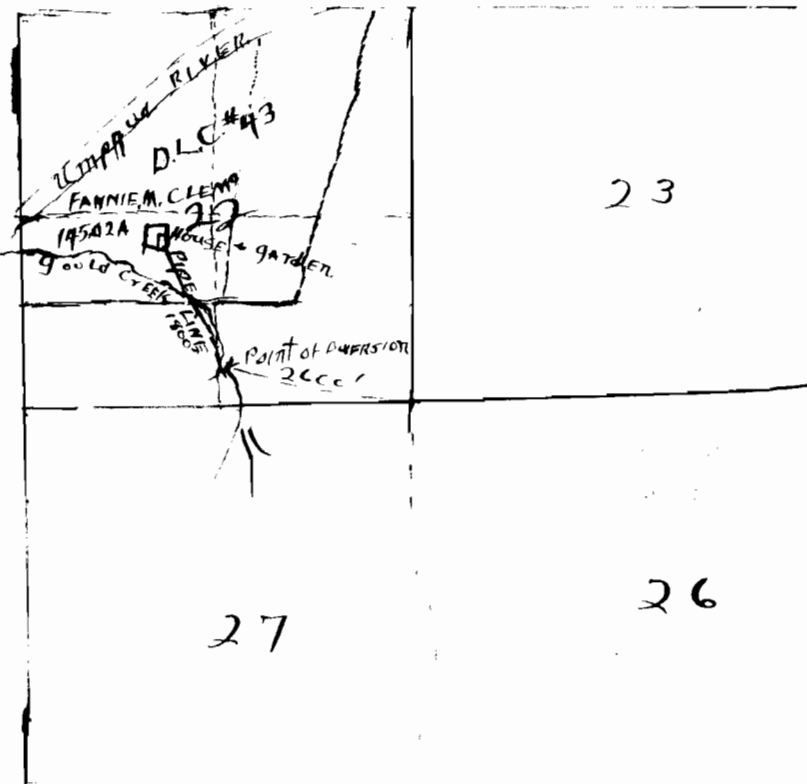

23

26

27

S.

Elkton

Application No. 10821  
 Permit No. 8831