


Sec. 4

Tp. 12 S.

R. 5 W.

point of  
diverston

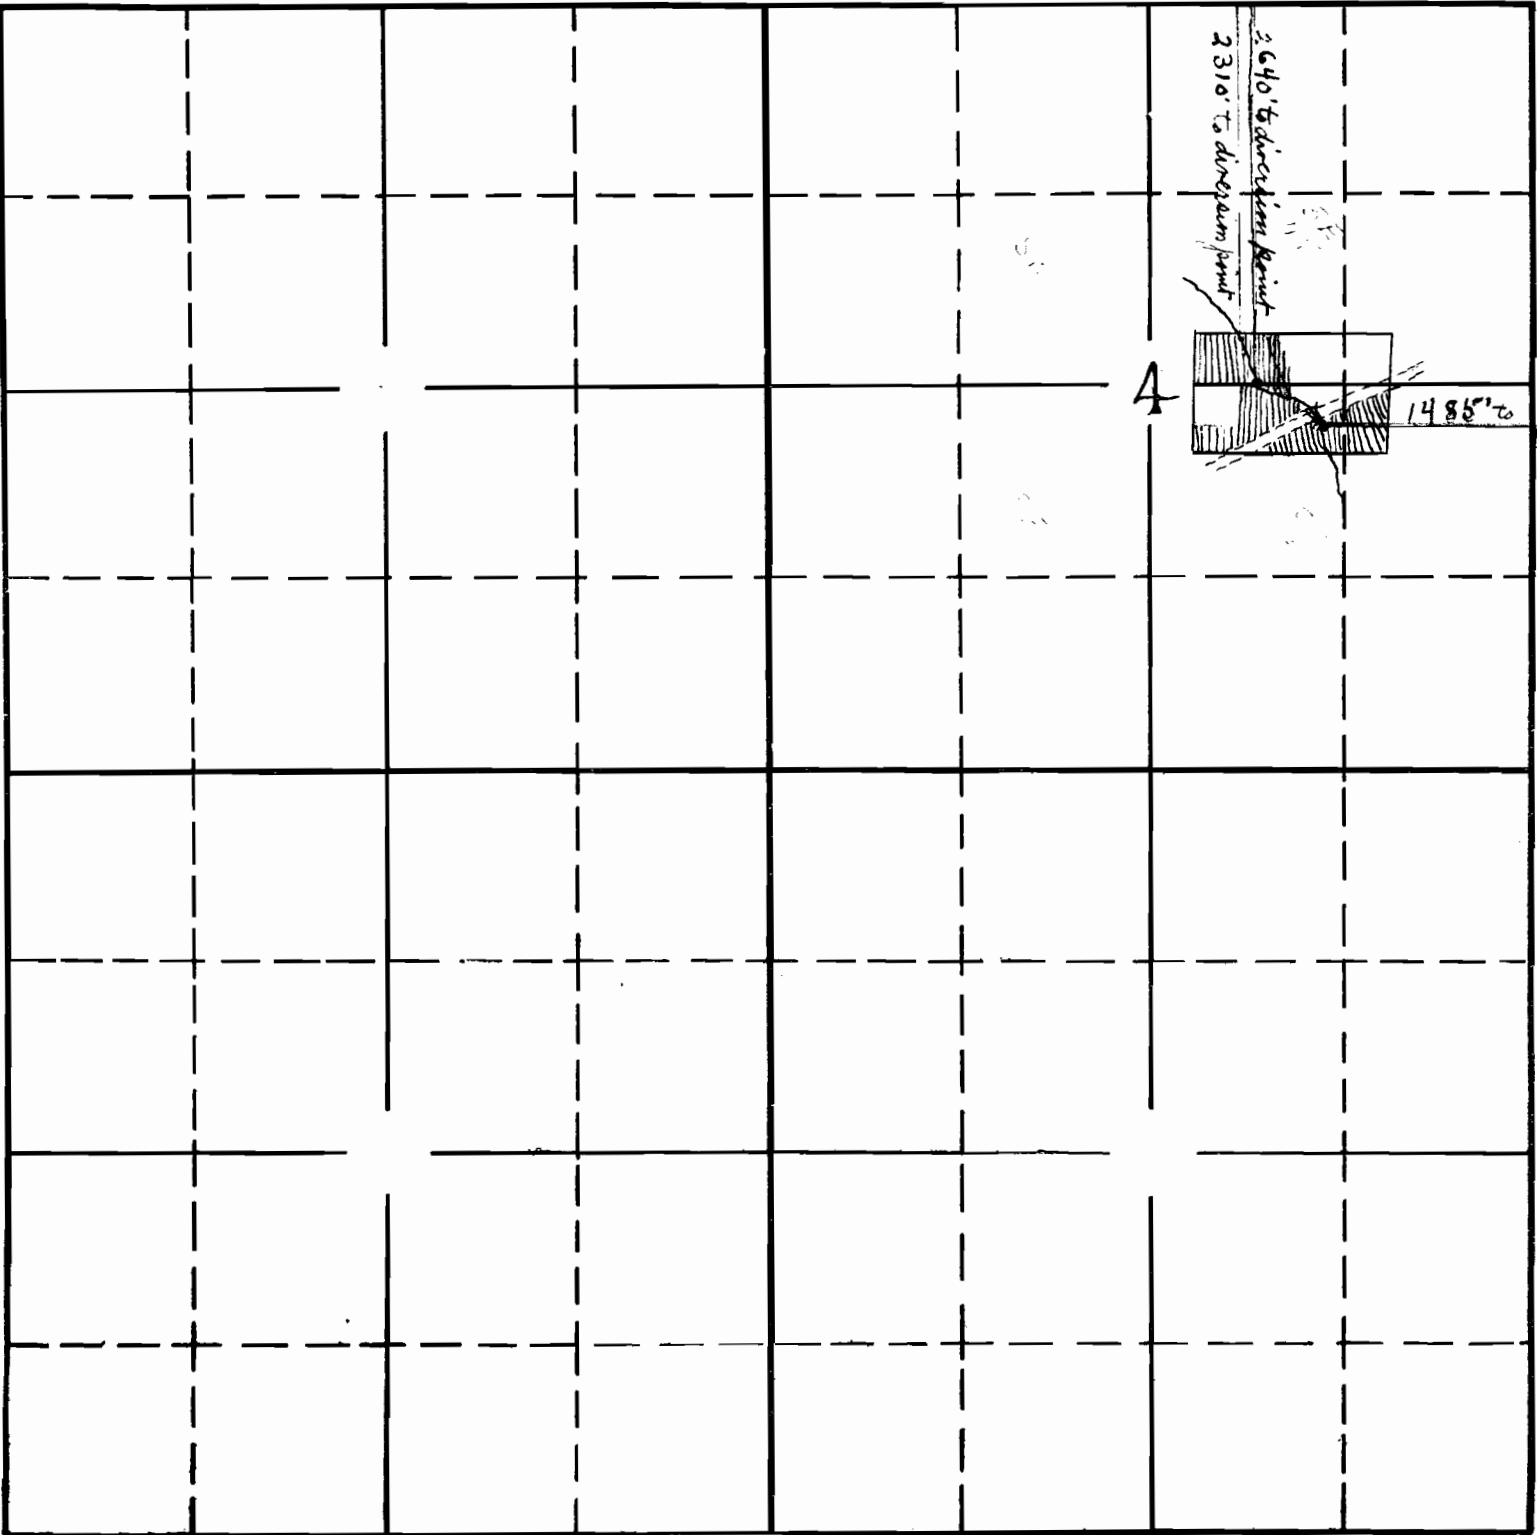

Application No. \_\_\_\_\_  
Permit No. \_\_\_\_\_

Scale : 1" = 80 rods or 1320 ft.