


SECTION

TOWNSHIP 85, RANGE 4W, W. M.

North

West

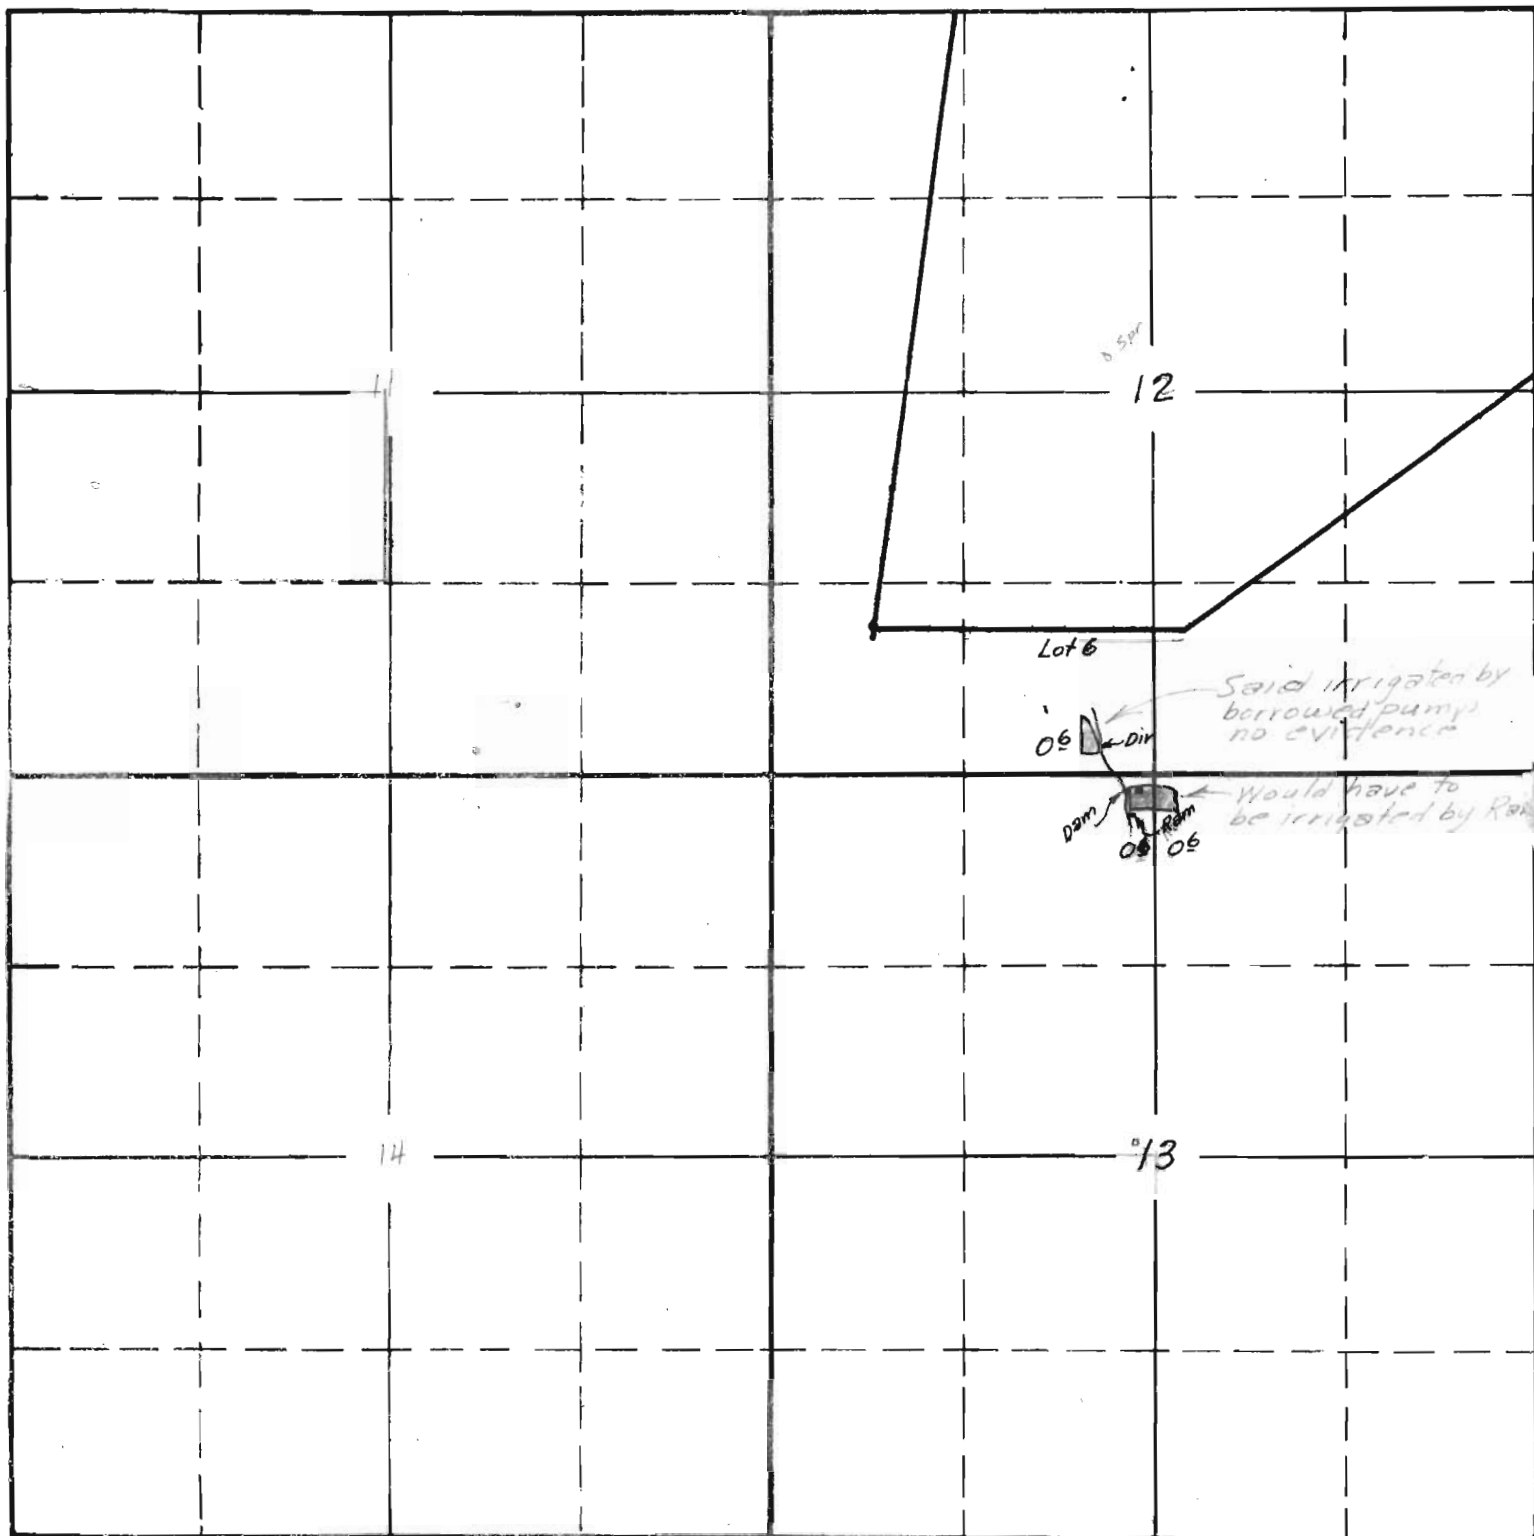

South

surveyed by C.A.B.
April 18 1939

APPLICATION No. 12257
PERMIT No. 8709