

600' N  
50' W from SE Cor. SW 1/4 NE 1/4


12481

Sec. 3

4

Tp. 4S

R. 3W

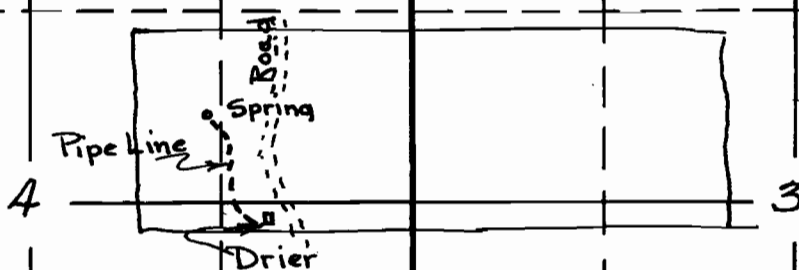

Application No. 12481  
Permit No. 8829