


Sec. 20

Tp. 33 S

R. 6 W.

12491

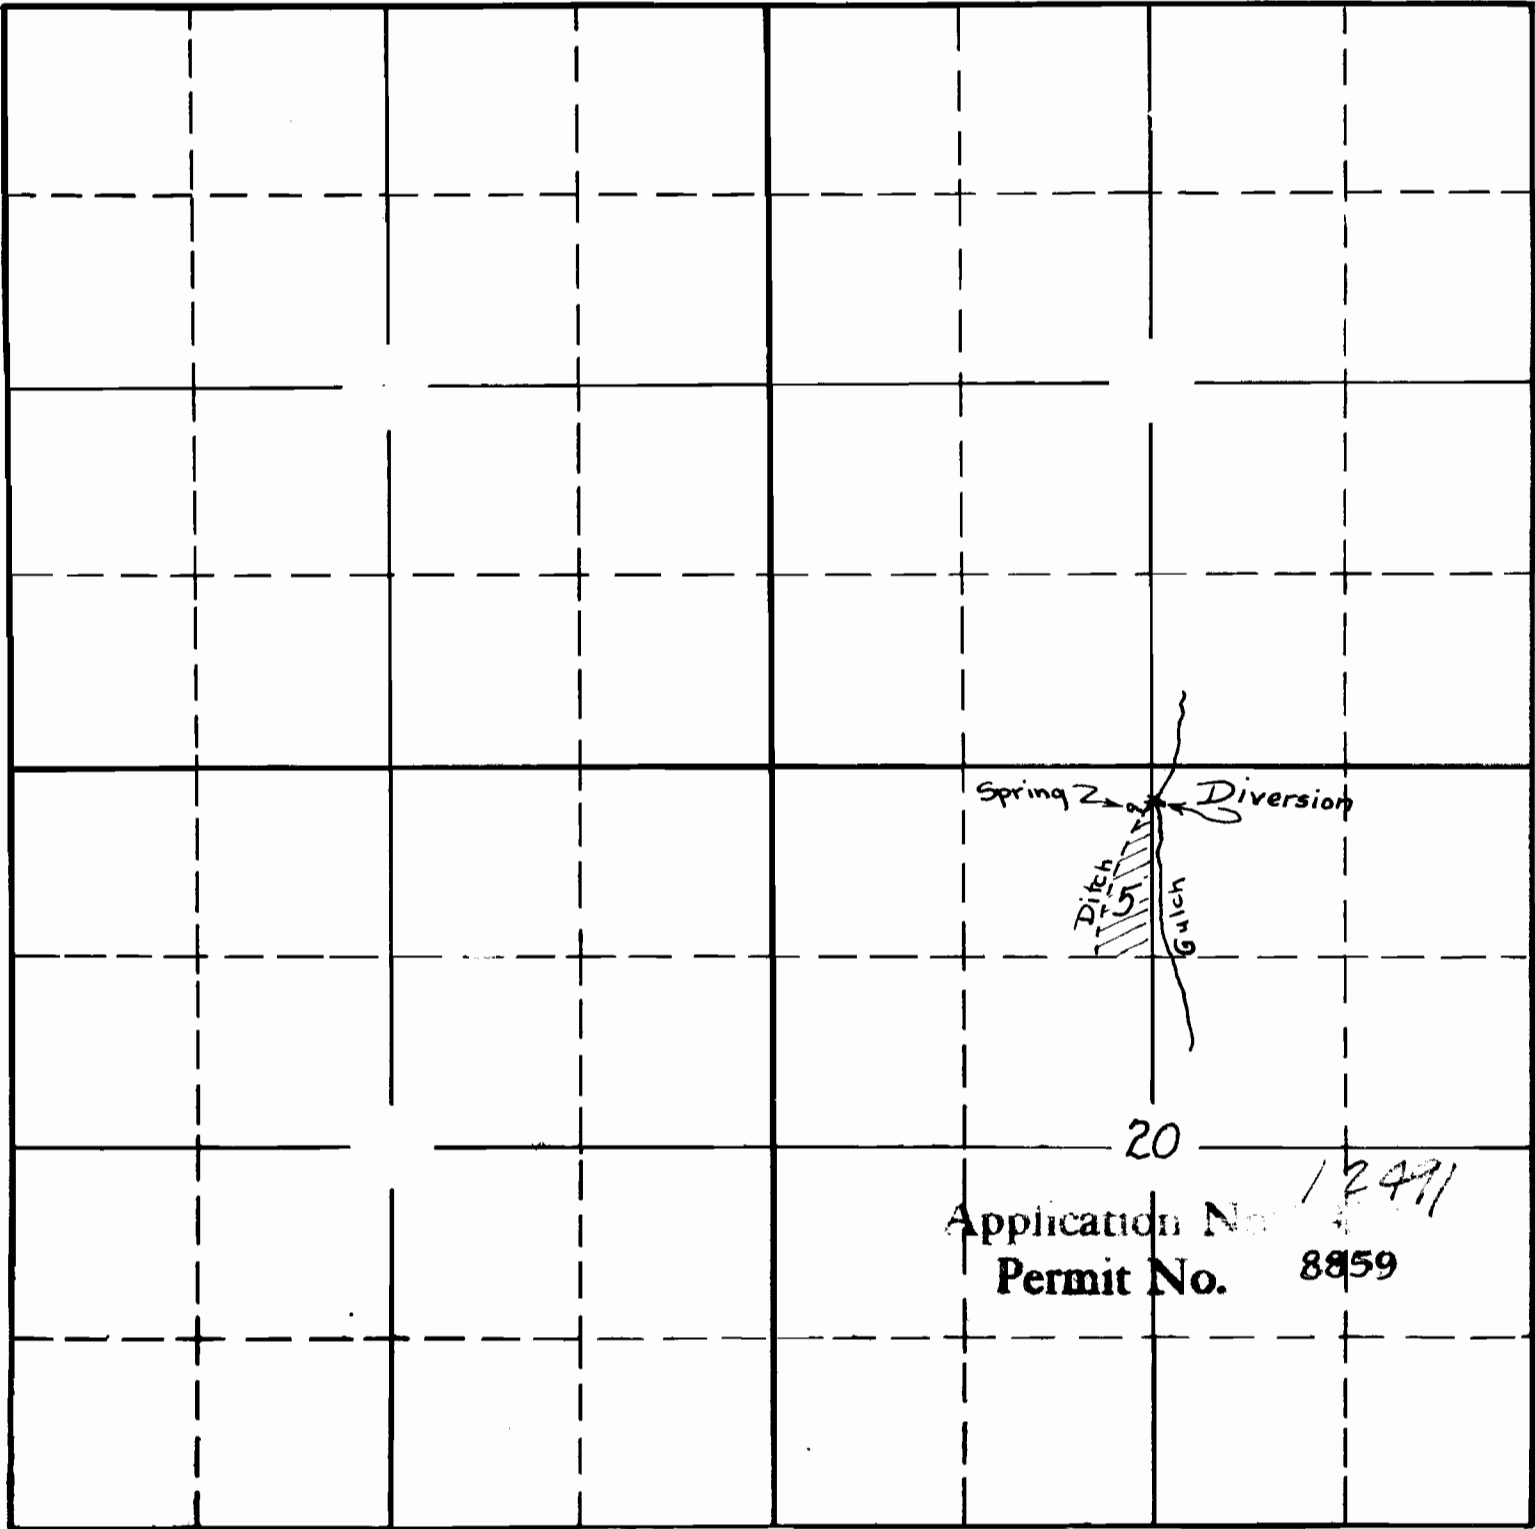

Spring 2

Diversion

Ditch

Gulch

20

Application No.

12491

Permit No.

8859

*Shanty survey this block*

*L.H. Olson*

*A-12491*