


Sec. 9


Tp. 7 N

R. 4 W

Ap. No. 12542

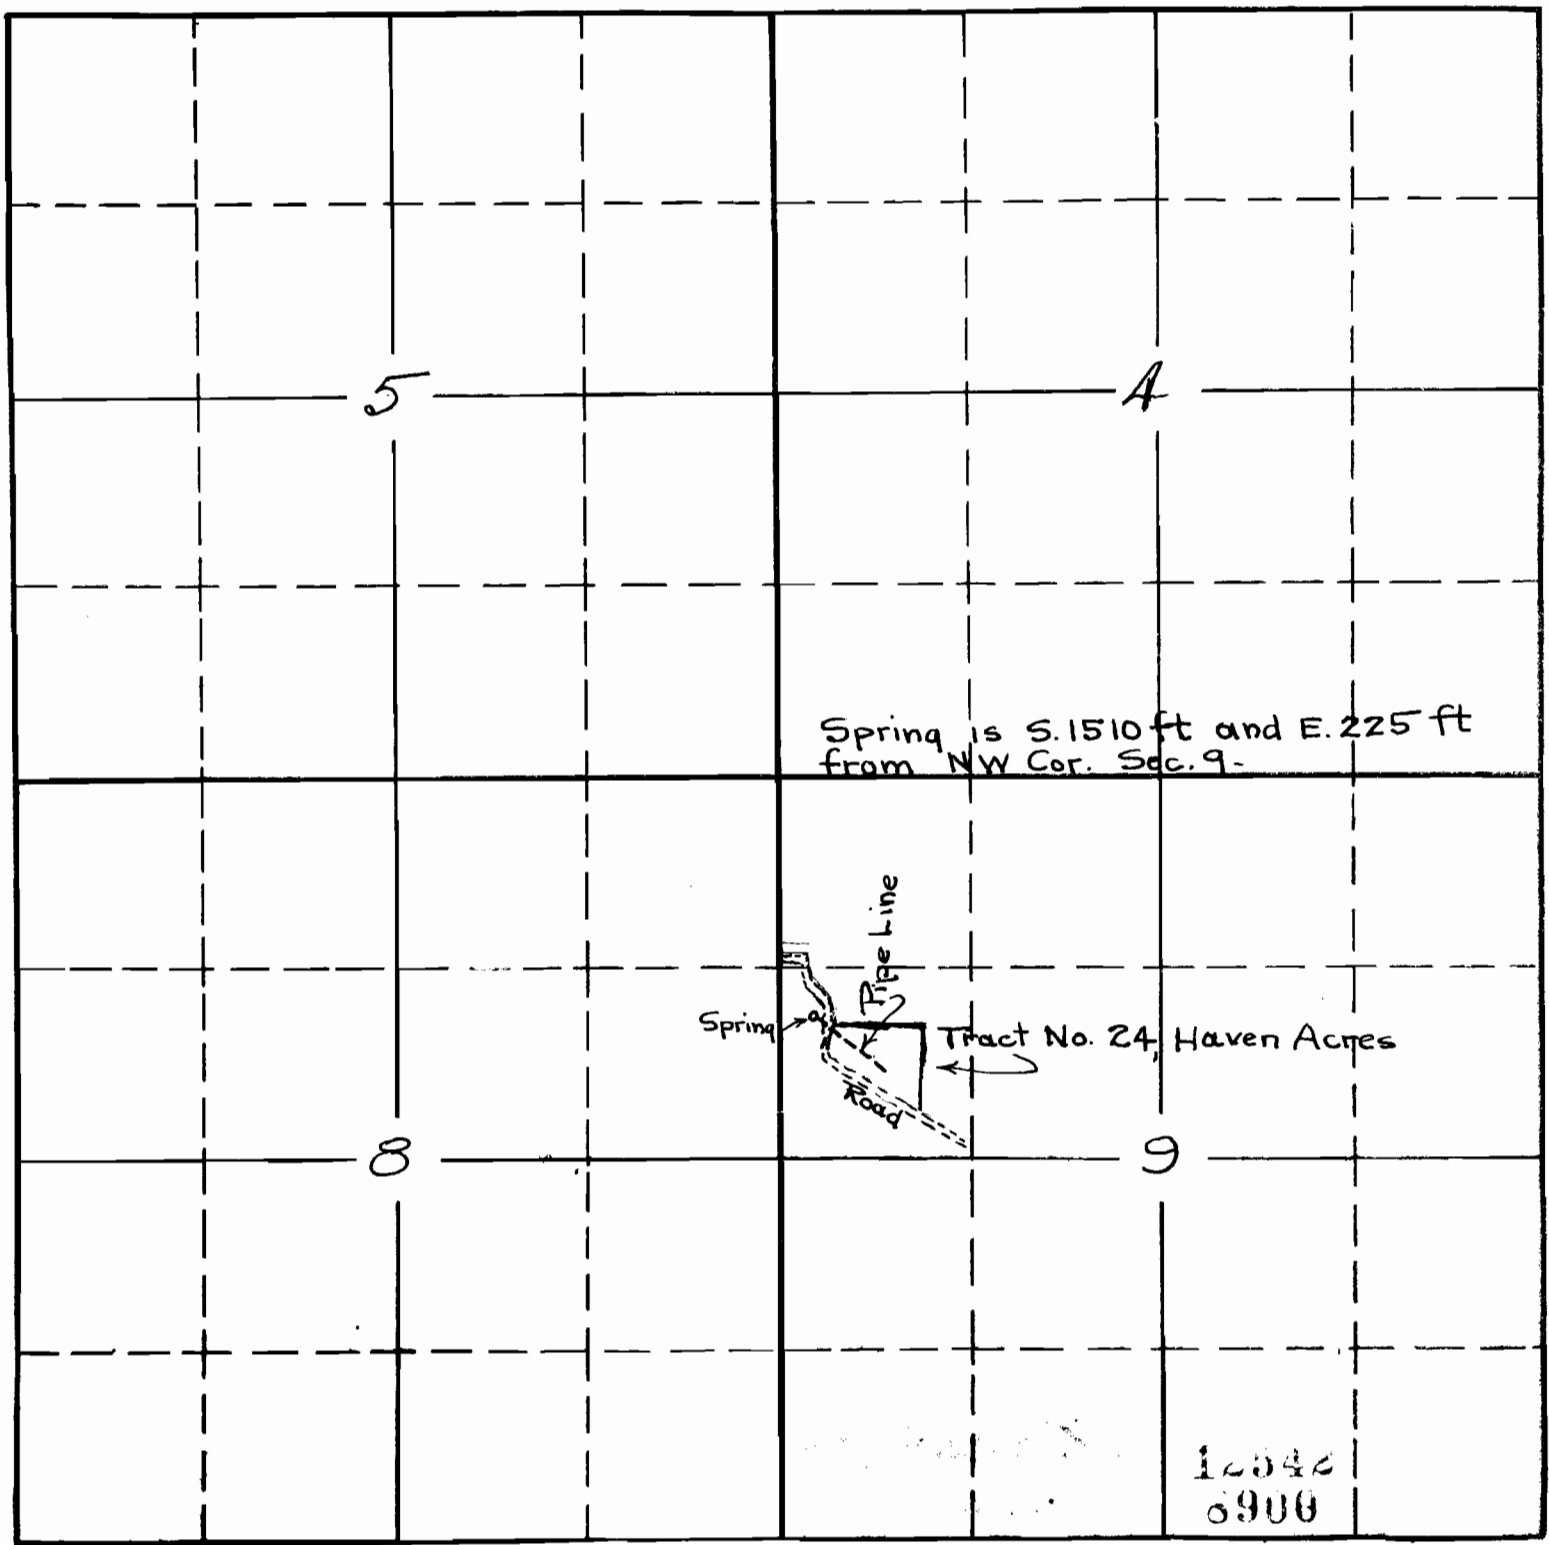

Spring is S. 1510 ft and E. 225 ft from NW Cor. Sec. 9-

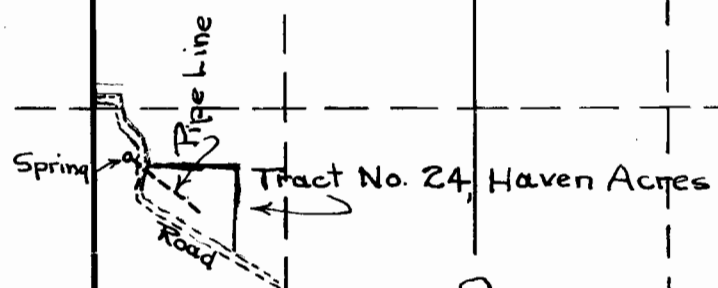

12542
