




Stone $\frac{1}{4}$ Corner
Center Section 17,
T. 4 S. R. 14 E. W. M.

I, David G. Glass, hereby certify that this map was made from notes taken during a survey actually made by me in October 1932 and that it correctly represents actual conditions.

David G. Glass
Registered Civil Engineer
Oregon No. 114

MAP
W. O. HADLEY FISH HATCHERY
SCALE 1" = 50'

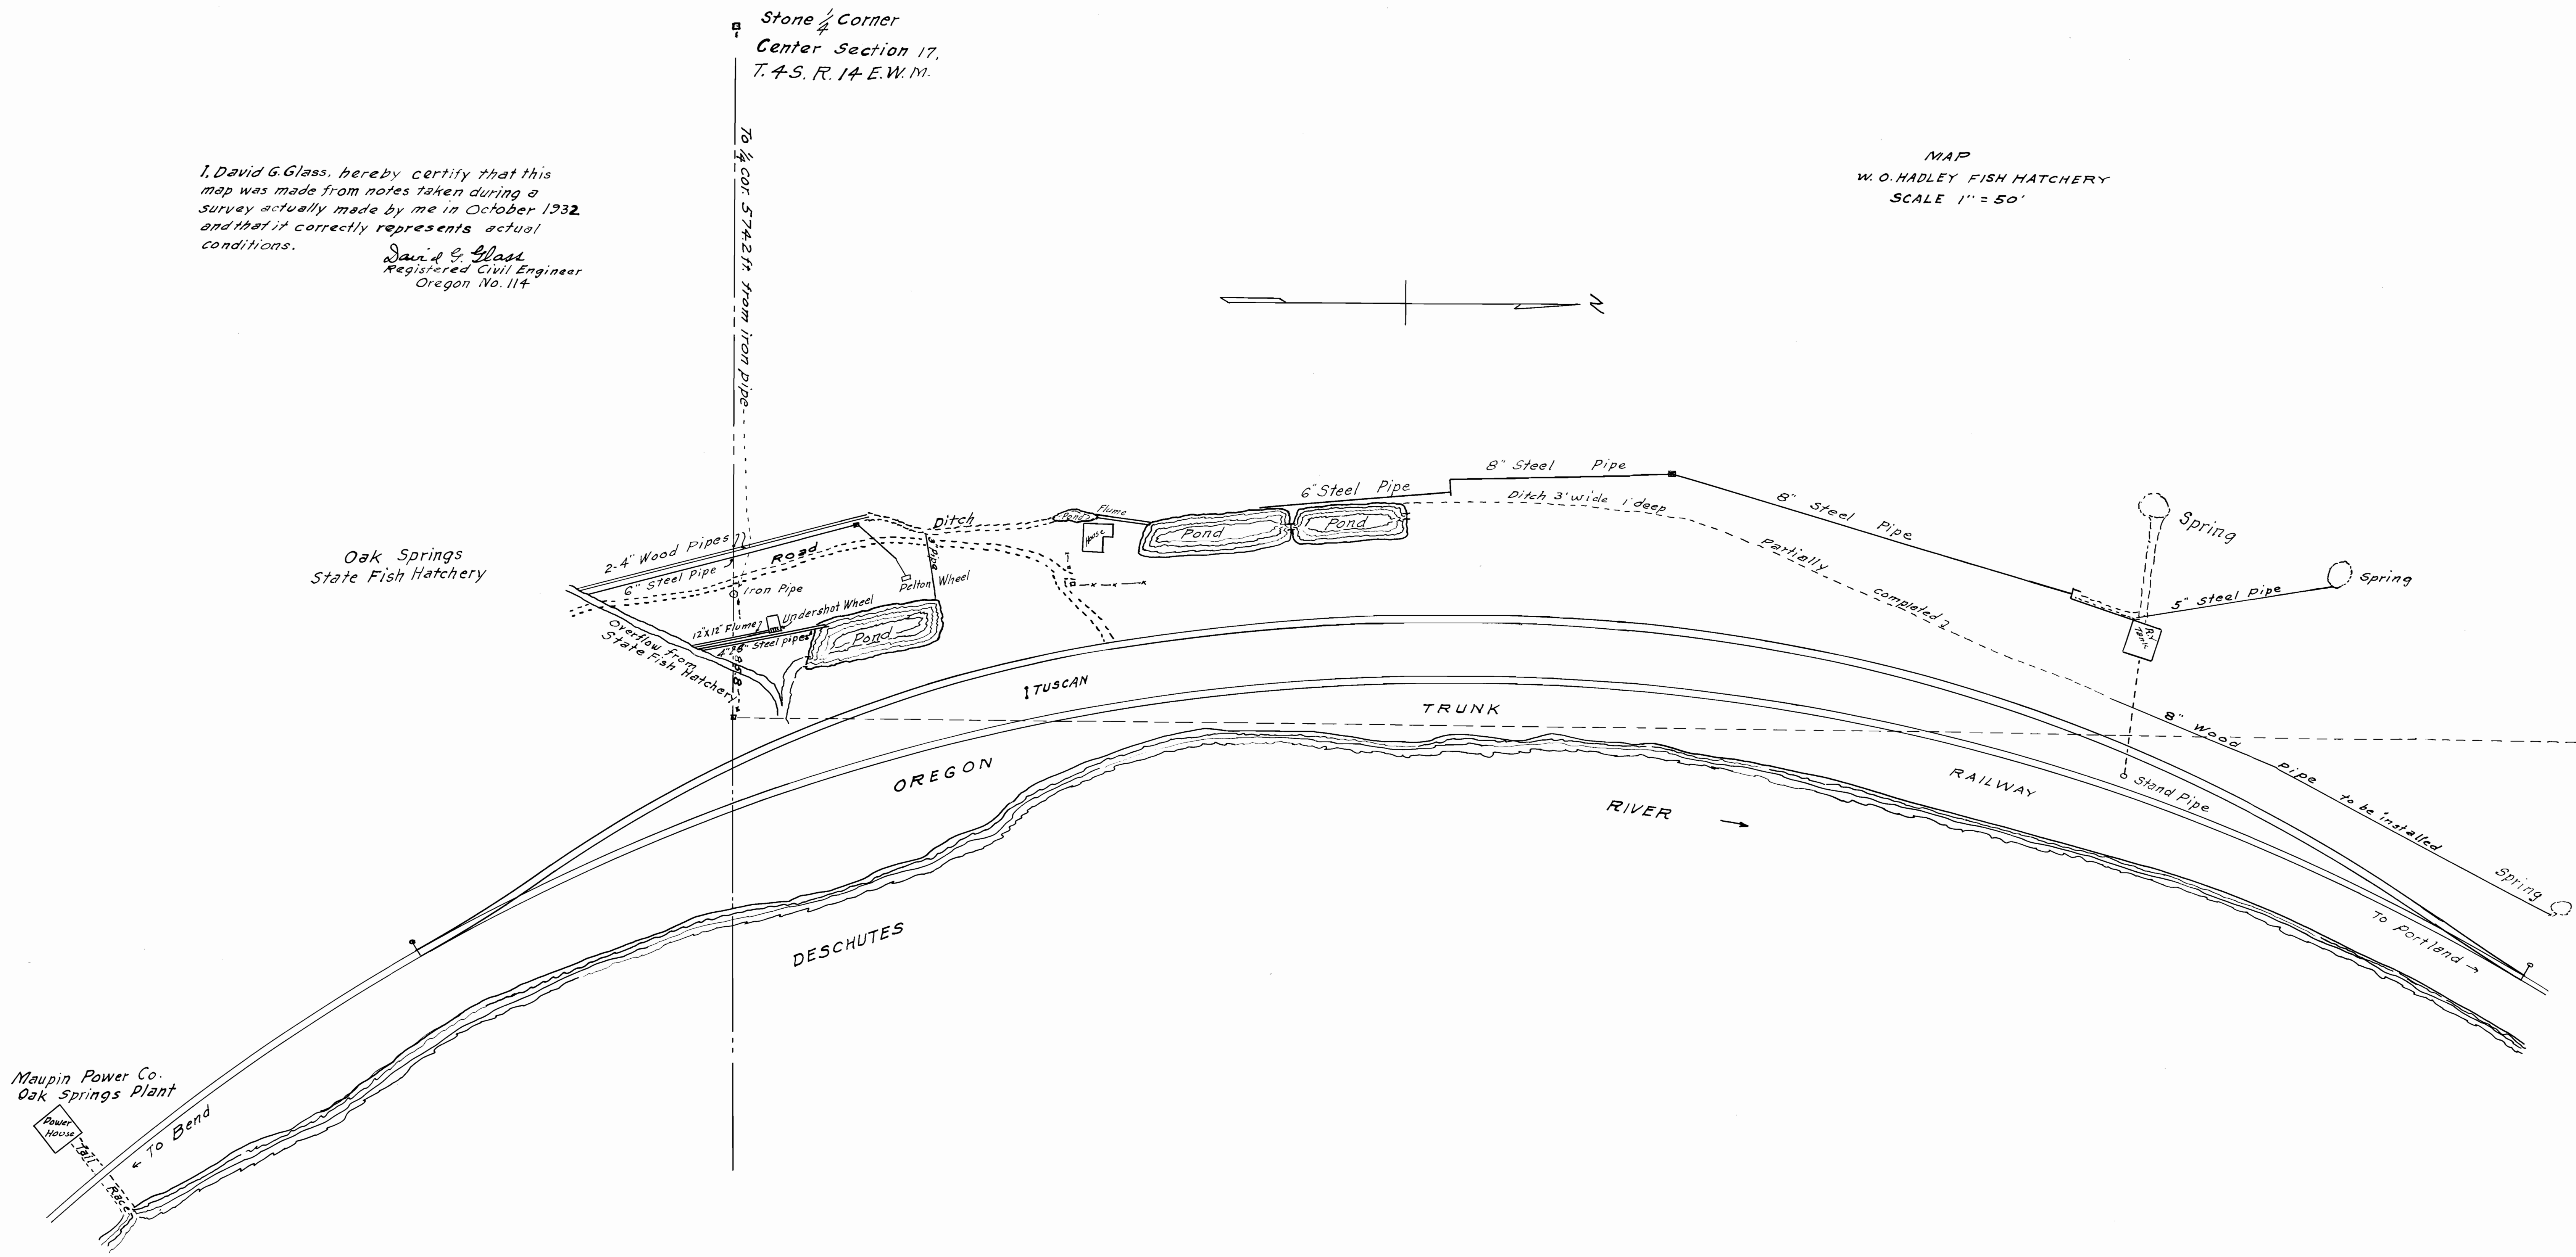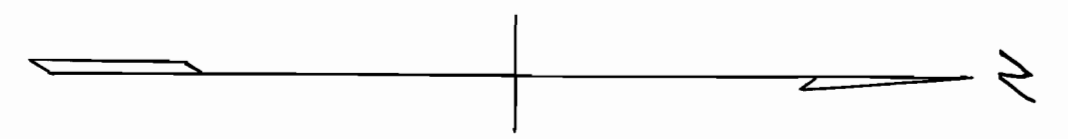

Oak Springs
State Fish Hatchery

Maupin Power Co.
Oak Springs Plant

Power House
To Bend
To Bend

TUSCAN
OREGON
DESCHUTES

TRUNK

RIVER

RAILWAY

Spring












Partially completed
to be installed
to Portland
Spring