


Application for domestic water supply

From unnamed creek

Intake point in S.E. $\frac{1}{4}$ of S.W. $\frac{1}{4}$ of Sec. 12 T. 8 S. R. 11 W. W.M.

Point of termination in N.W. $\frac{1}{4}$ of N.W. $\frac{1}{4}$ Sec. 13 T. 8 S. R. 11 W. W.M.

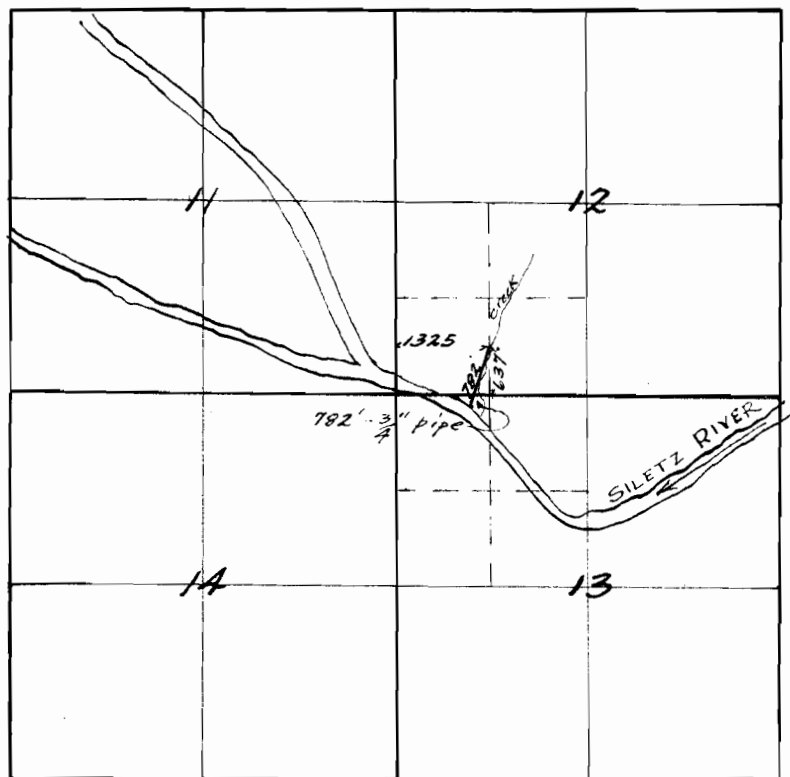

Scale 2" = 1 mile

I, H.M. Teel, county surveyor of Lincoln County, Oregon, do hereby certify that this map was made from notes taken during an actual survey made under my direct supervision on Jan. 3, 1929 and that it correctly represents the work described in the accompanying application together with the location of streams and other ditches in the immediate vicinity.

H.M. Teel

Registered Professional Engineer

Oregon No. 1013

Date of registration May 8 1926

Application No.

12517

8926