
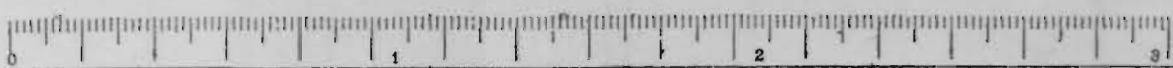


Township 30,

Range No 5 West.

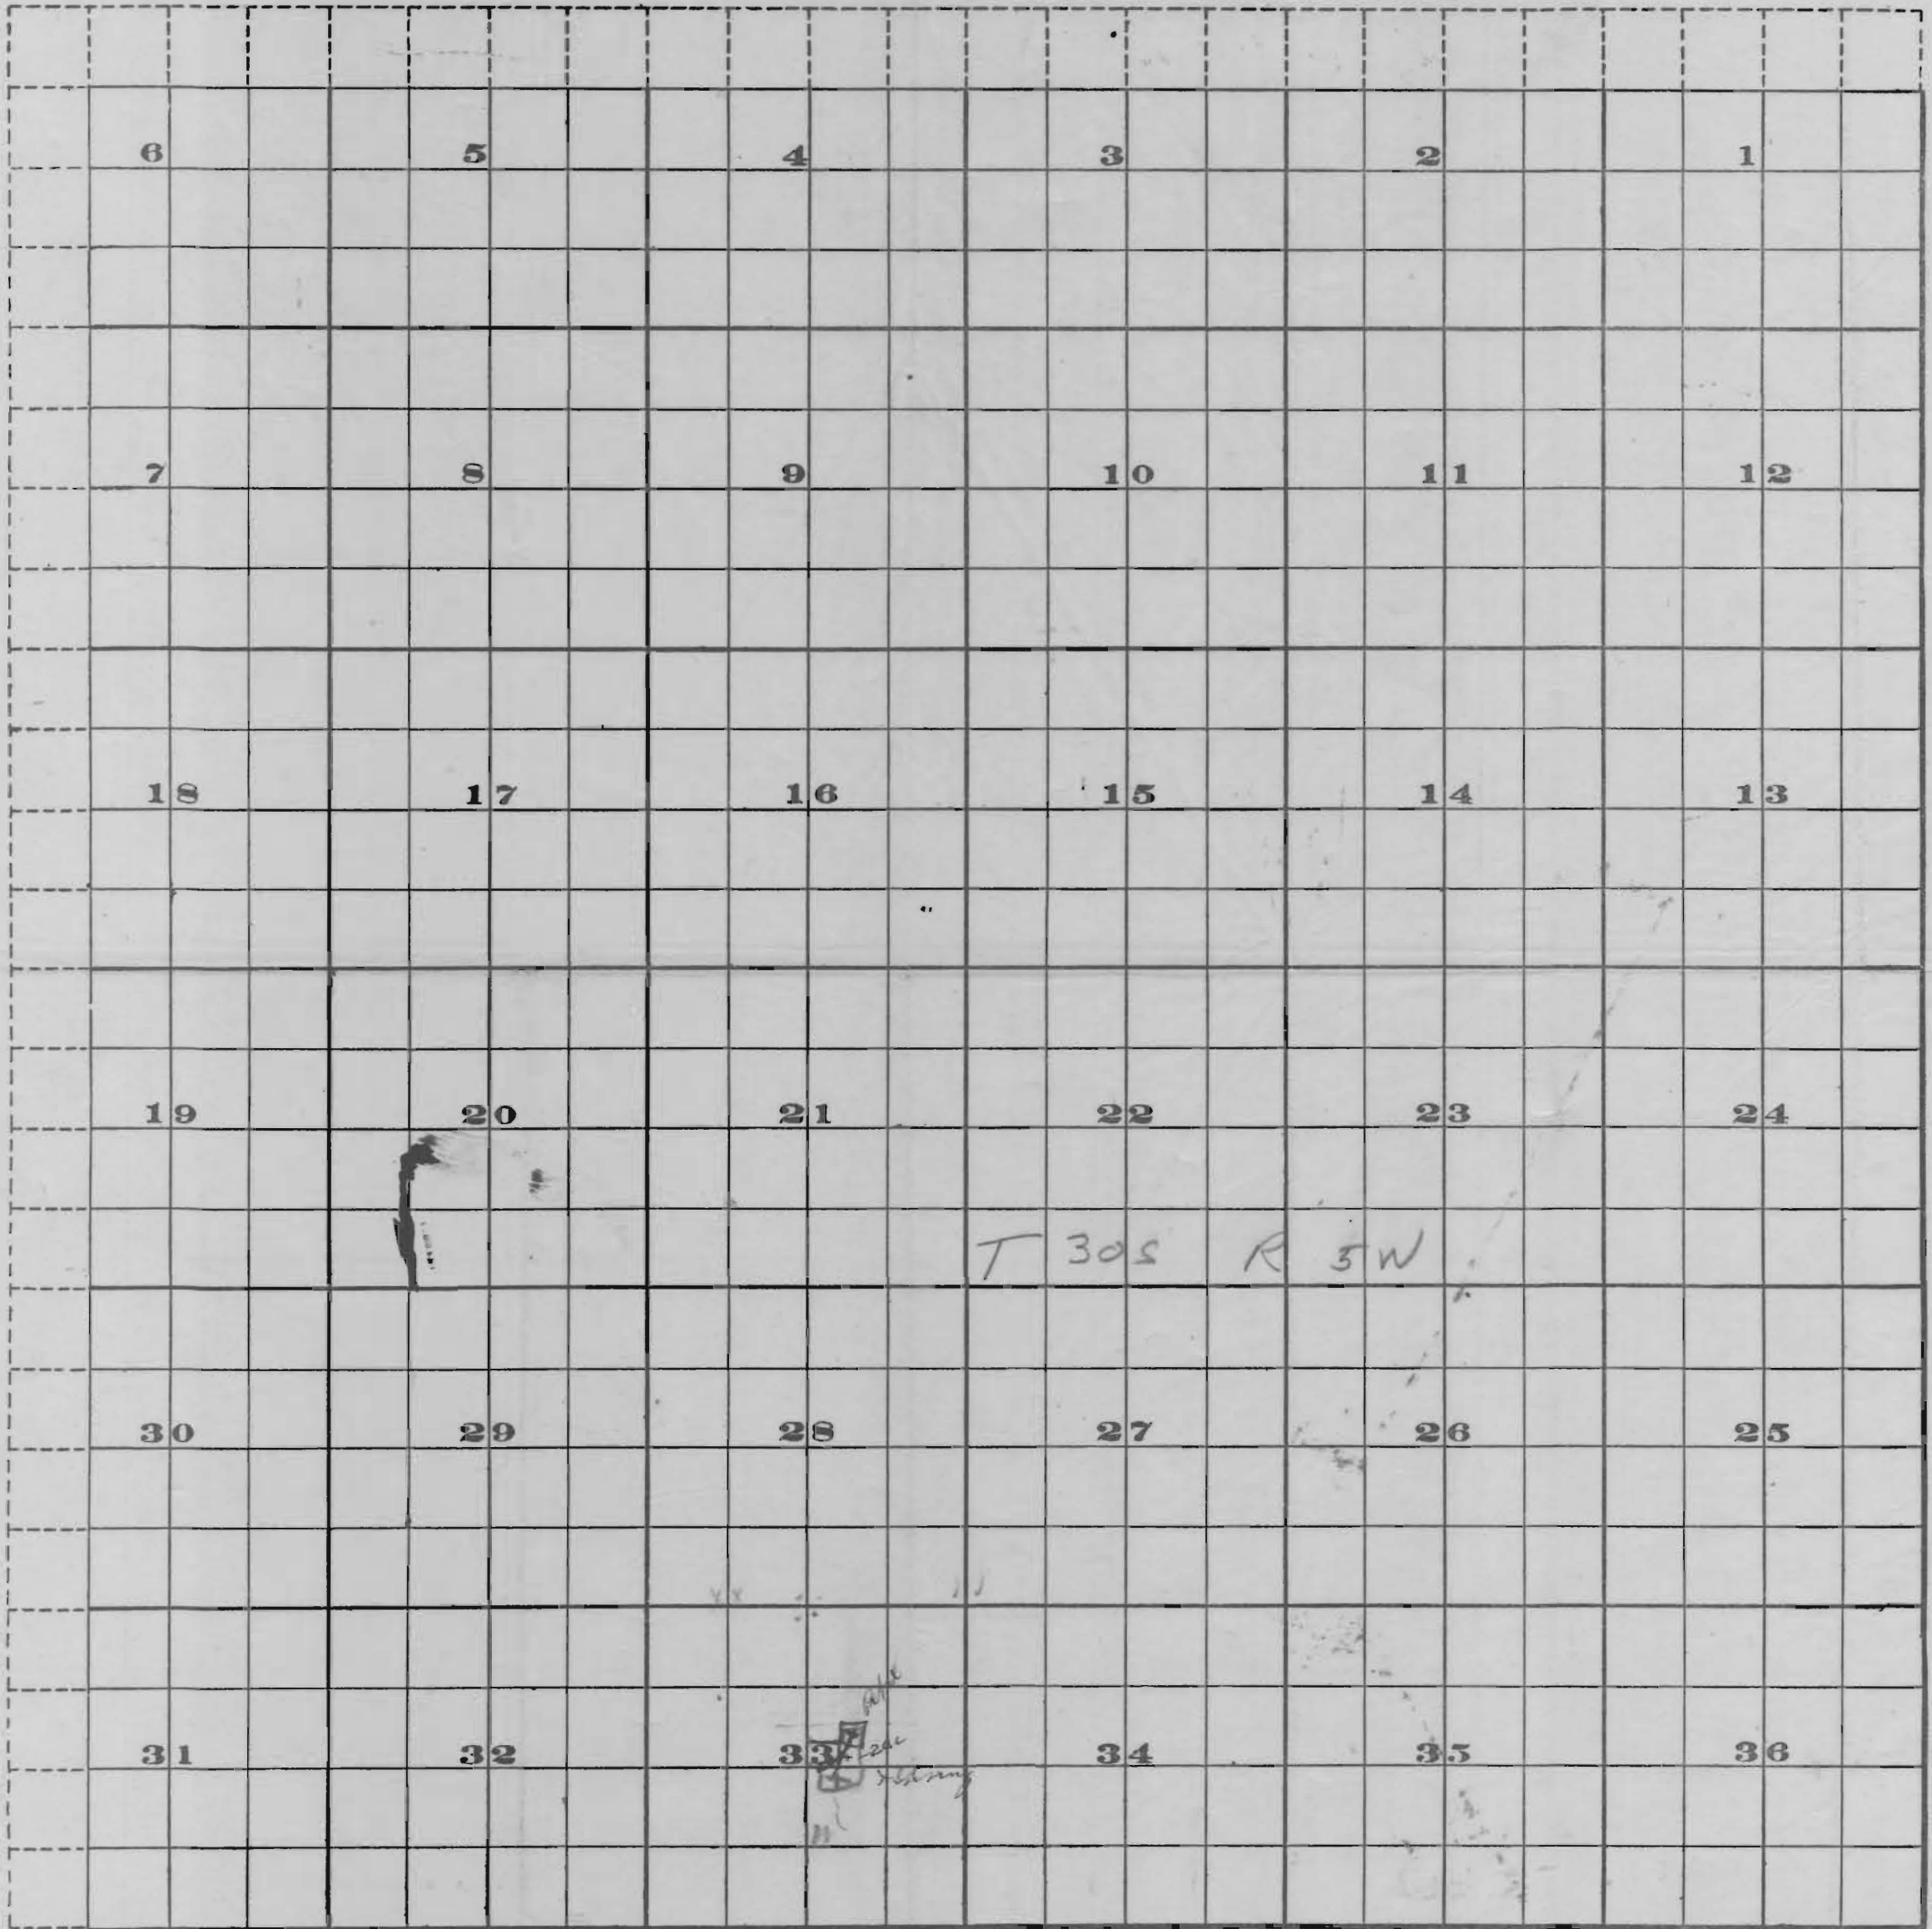

Scale of Feet.

FROM OFFICE OF THE STATE ENGINEER, MALEM, OREGON

OFFICE OF STATE ENGINEER

RECEIVED

OCT 26 1911

SALFM. OREGON

Application No. 1707
Permit No. 893

1505