


Map Showing Intake and
Location of Approx. 30 A Land
For Vic Butler Sec 20 T 14 R 14 E "1M"
Scale 2"=1M.

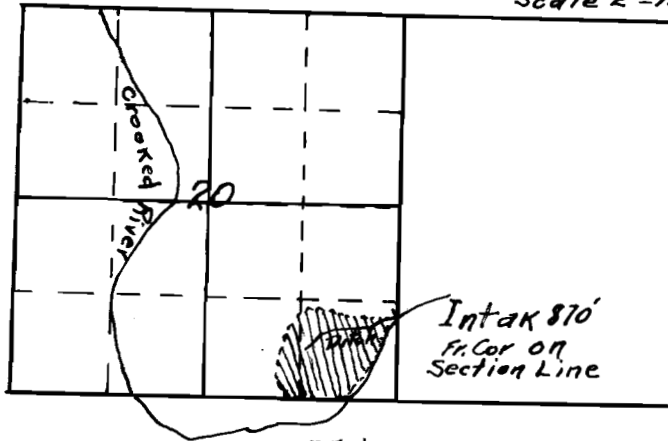

7A. in SW $\frac{1}{4}$ SE $\frac{1}{4}$
23A SE $\frac{1}{4}$ SE $\frac{1}{4}$

Application No. 12658
Permit No. 12658