


The land to be irrigated is a metes and bounds tract lying on the North side of Mill Creek between 14<sup>th</sup> and 15<sup>th</sup> Streets

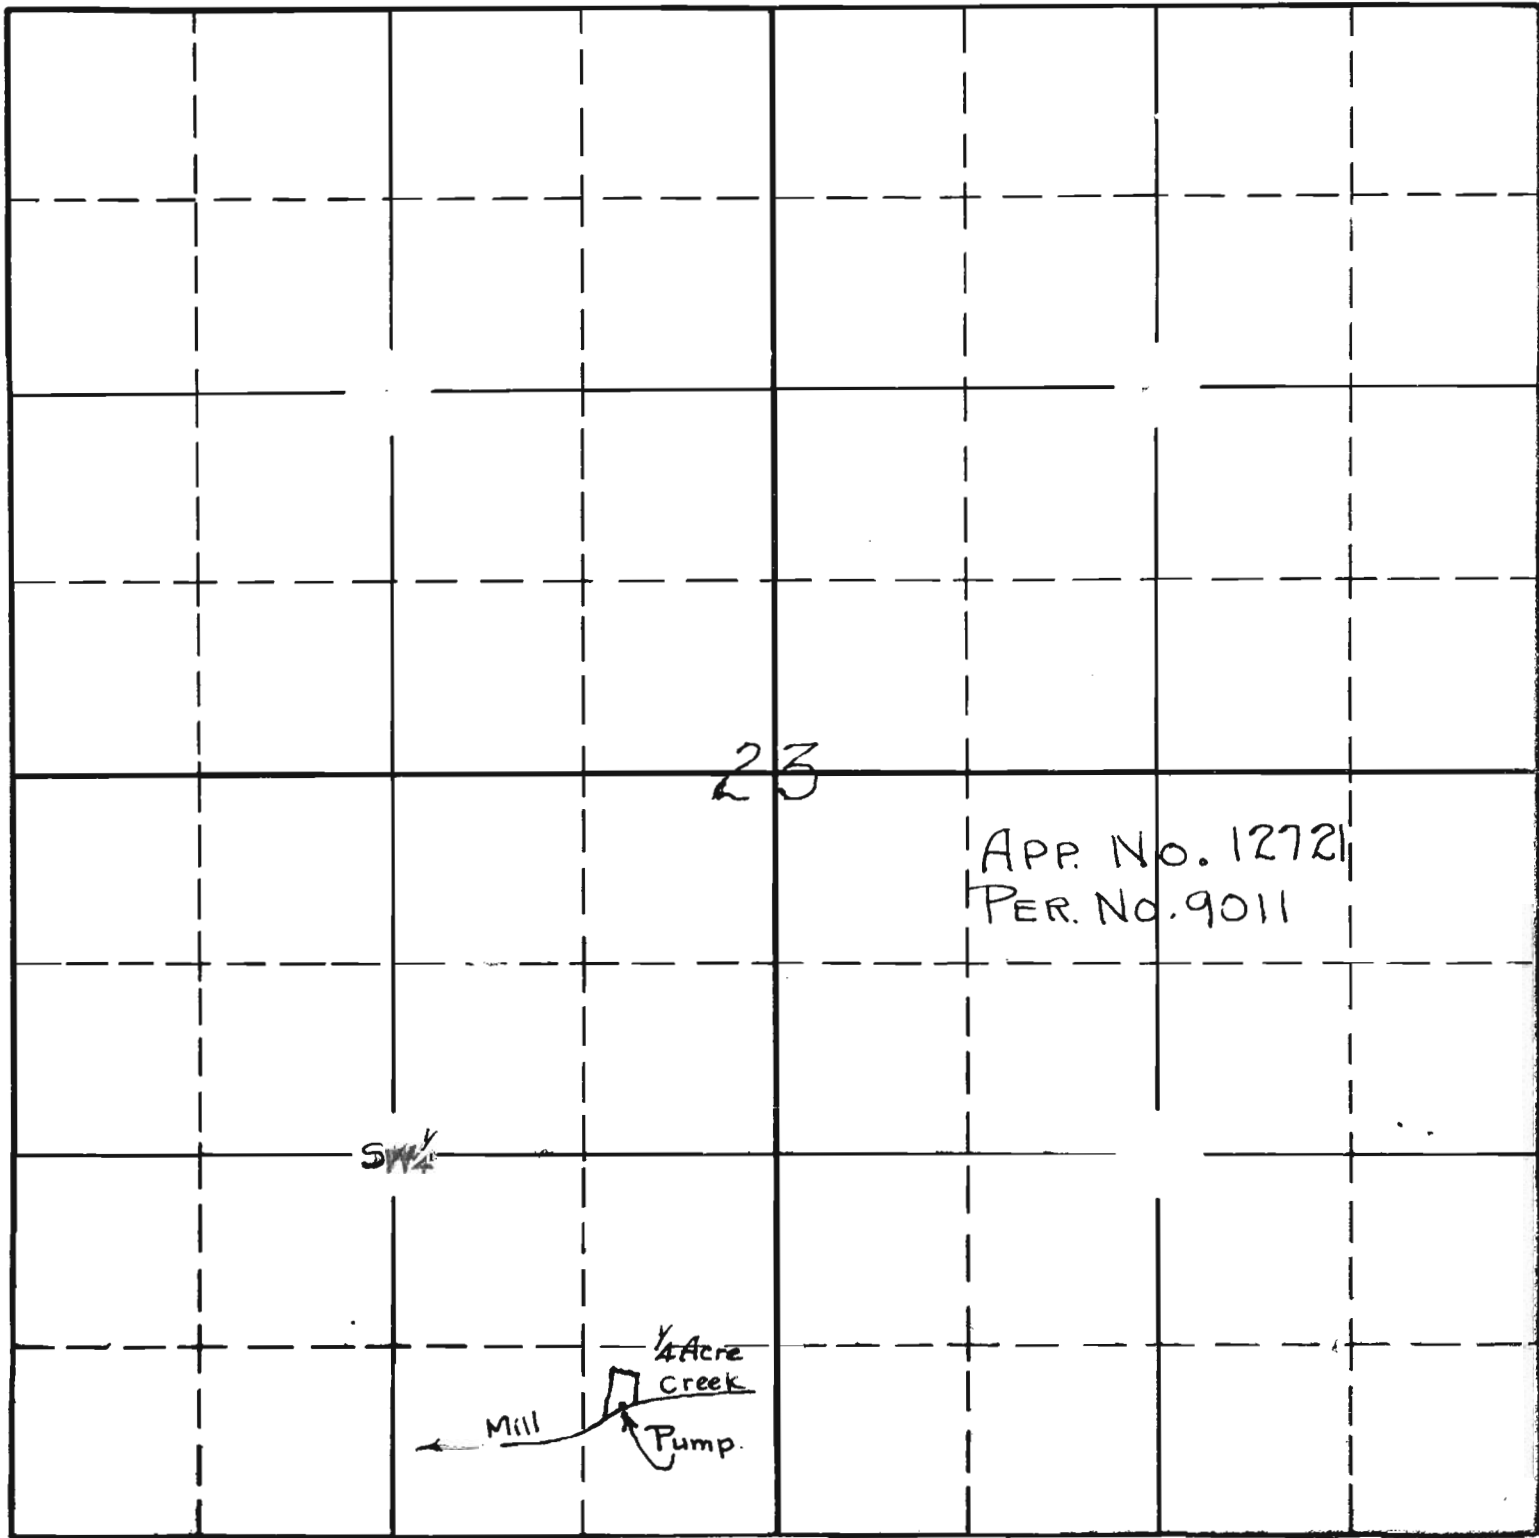

Sec. 23

Tp. 7S

R. 3W