

Sec. 16


17

20

21

Tp. 10 S

R. 10 E.

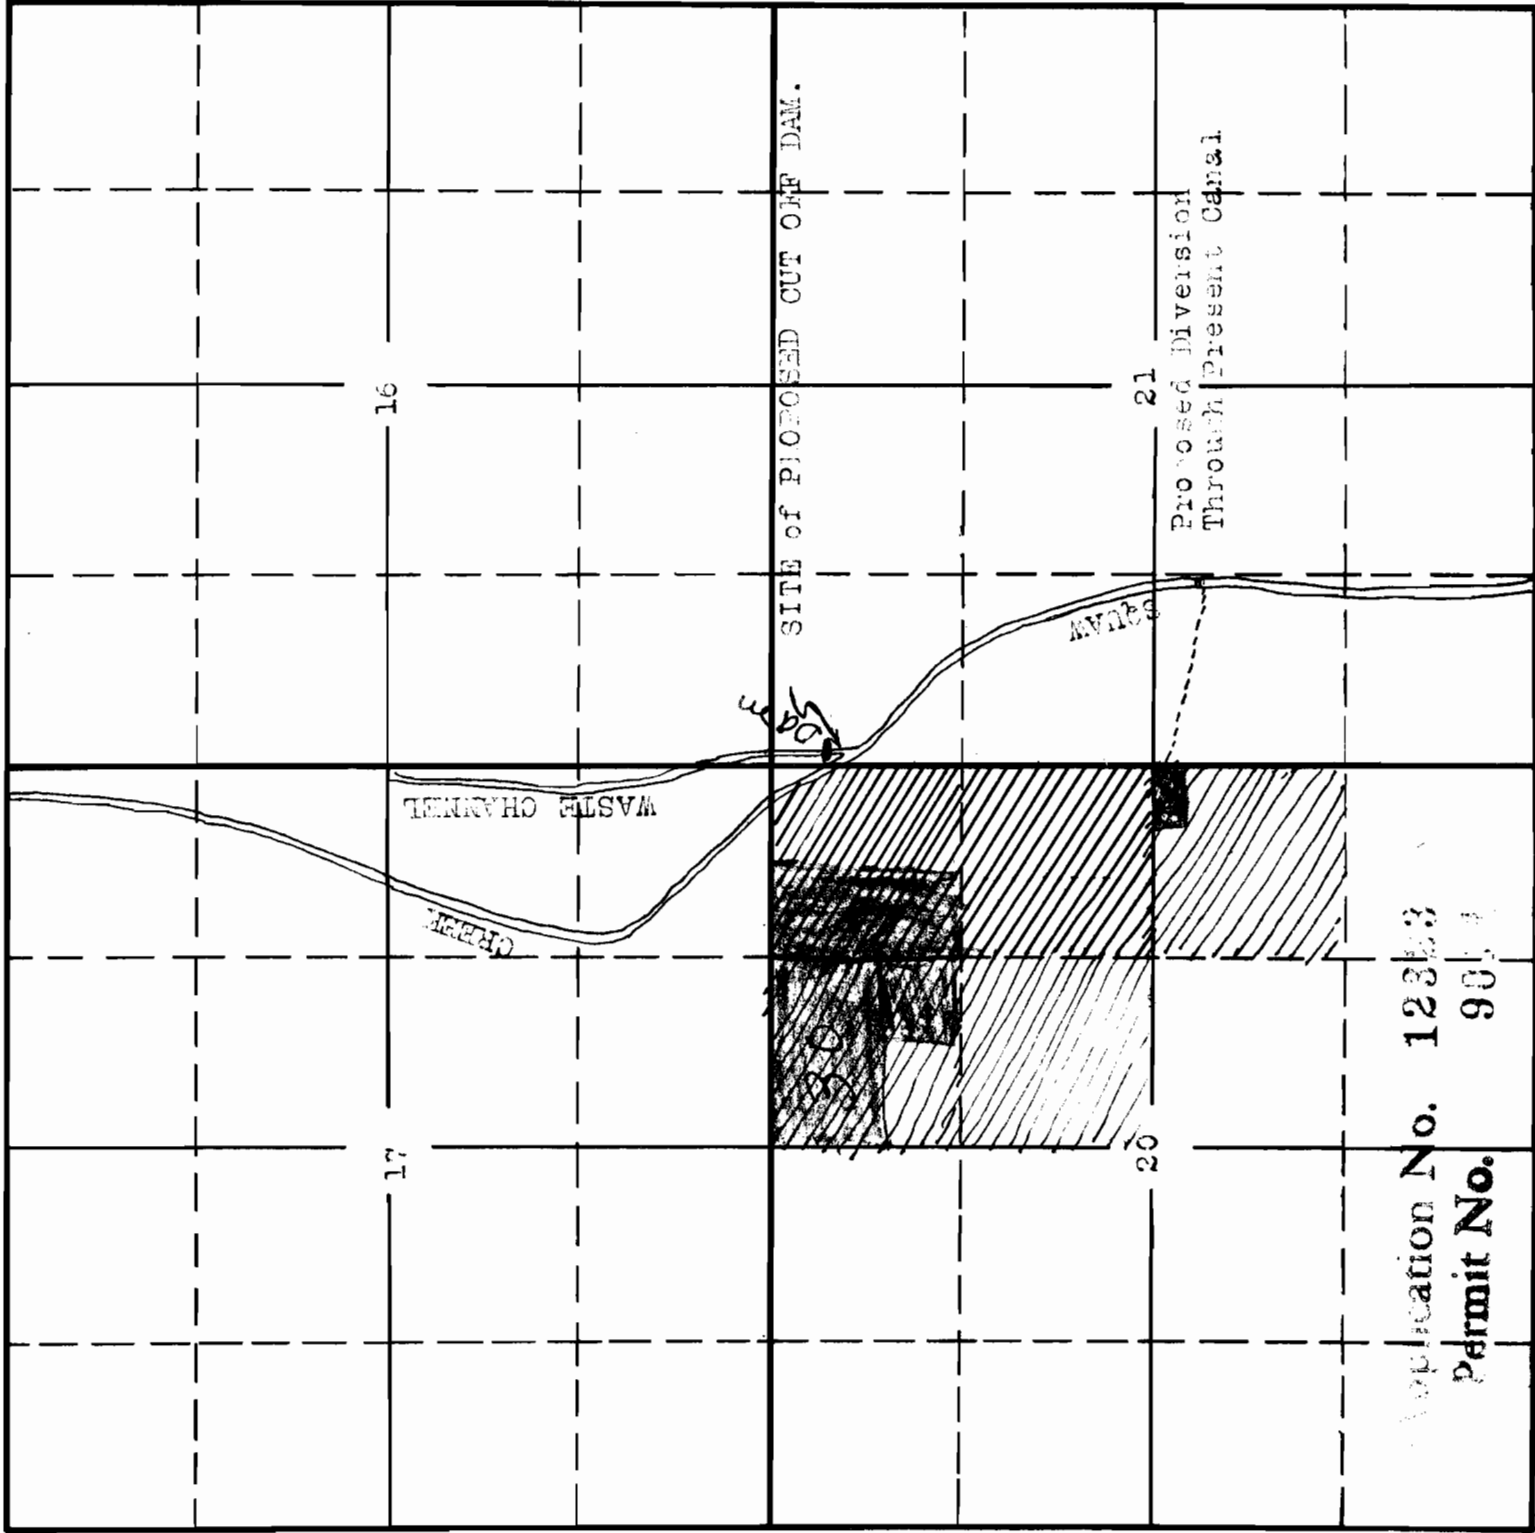

Application No. 12353

Permit No. 9014