


Application No. 12638
Permit No. 9026

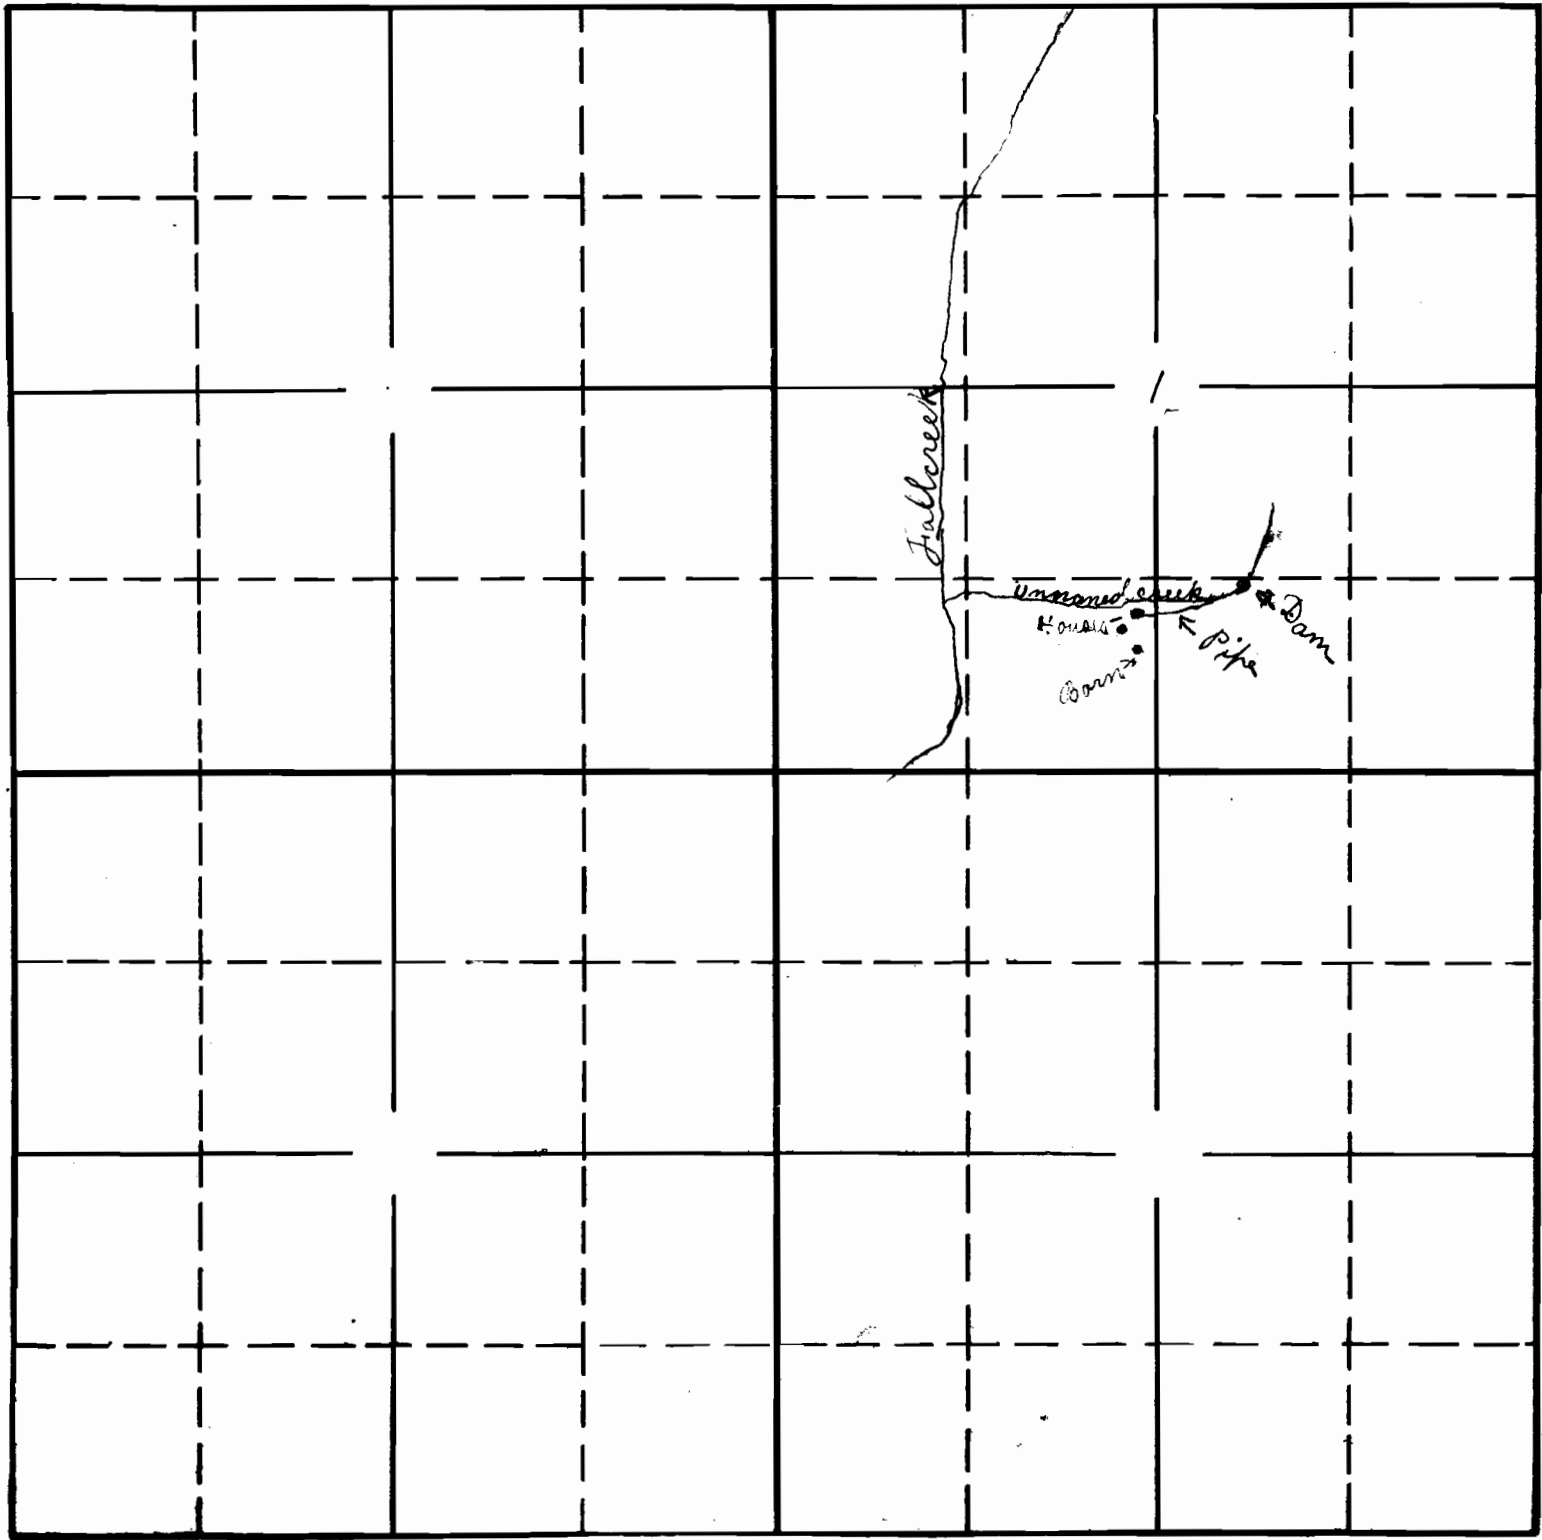

Sec. 1

Tp. 14. S
R. 9. W.
Willamette
Meriden
Oregon