


Sec. 2  
N 1/2 Lot 3  
\_\_\_\_\_  
\_\_\_\_\_  
Tp 25  
R. 44E

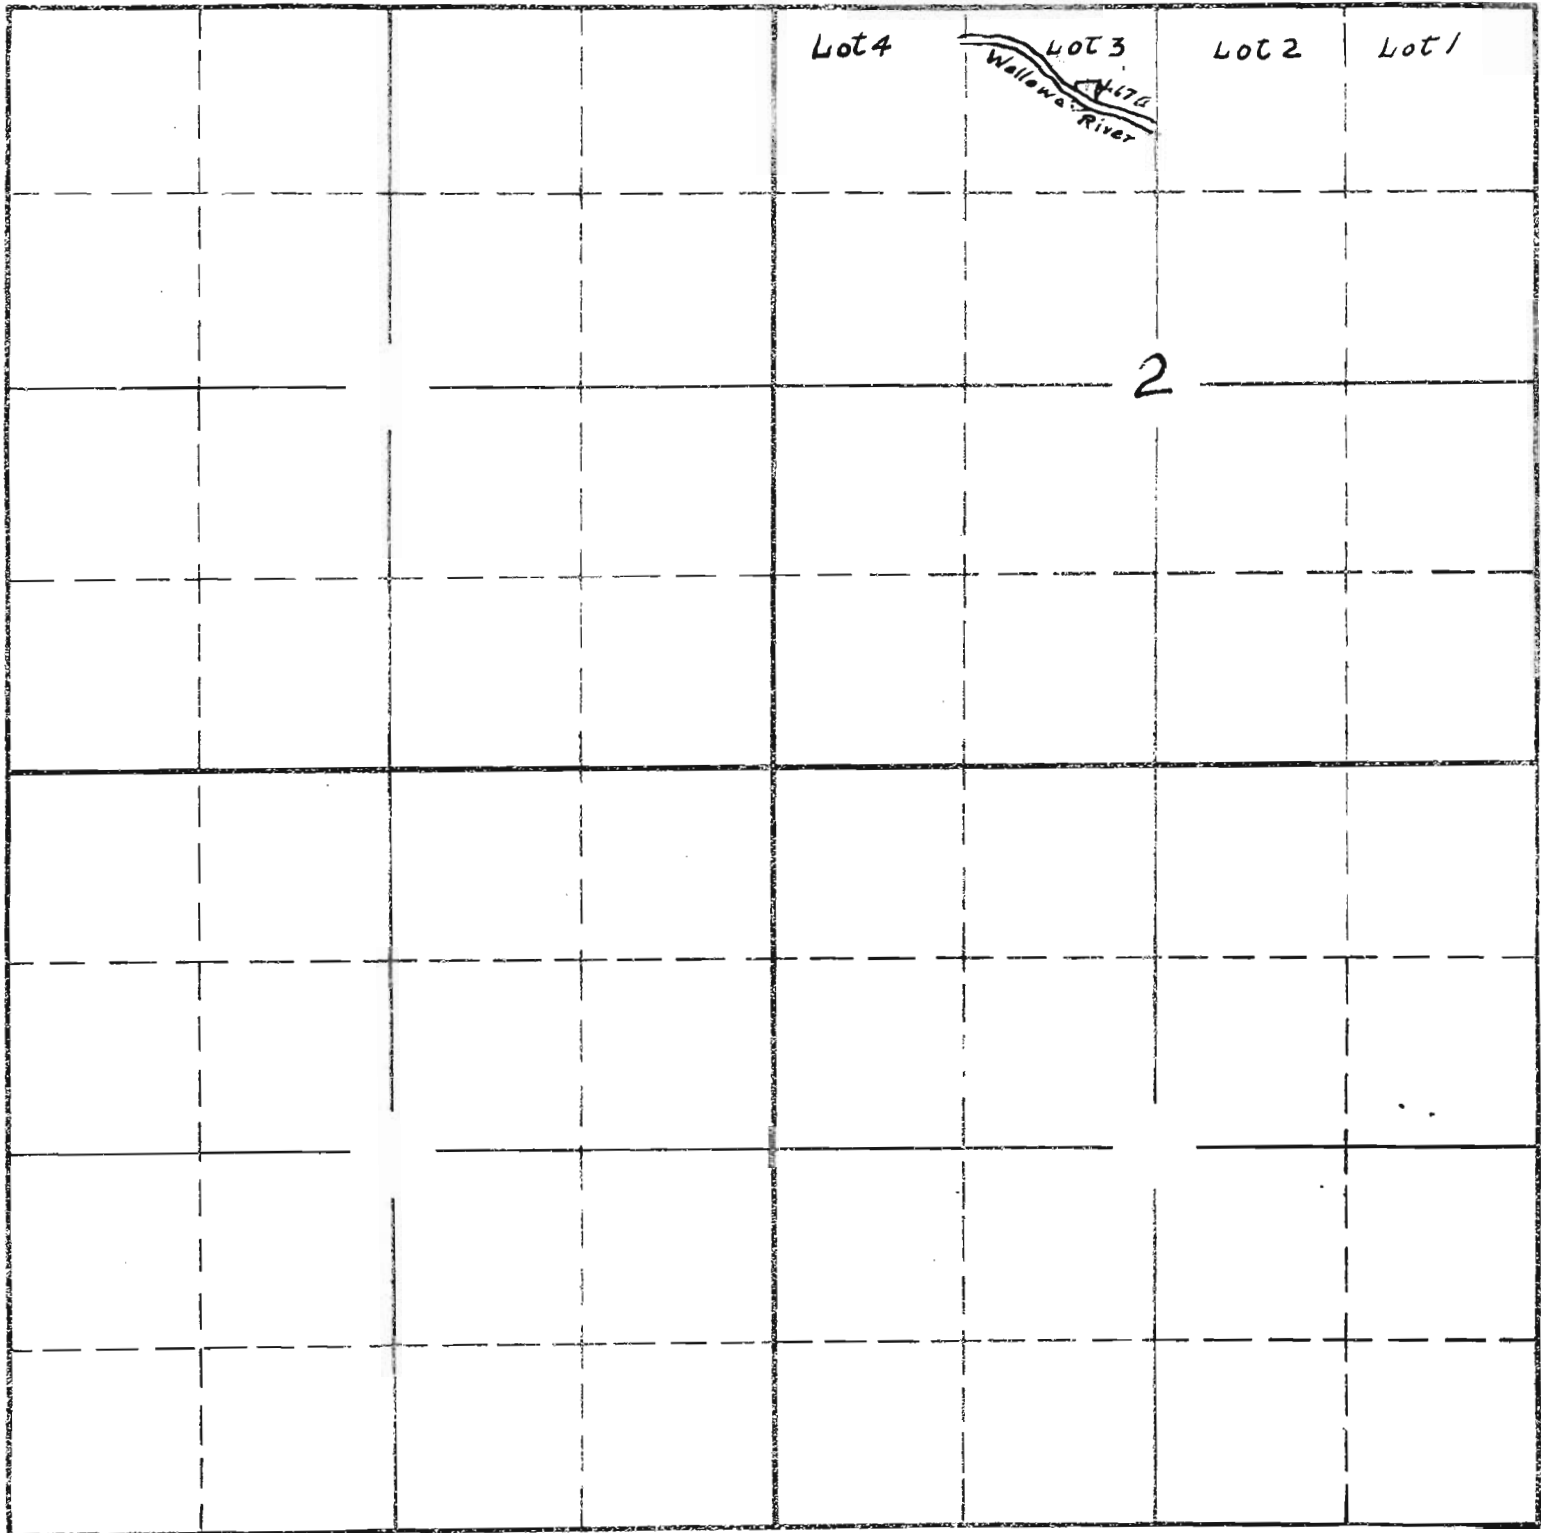

Application No. 12795  
Permit No. 9101