


Application No. 12217  
Permit No. 918

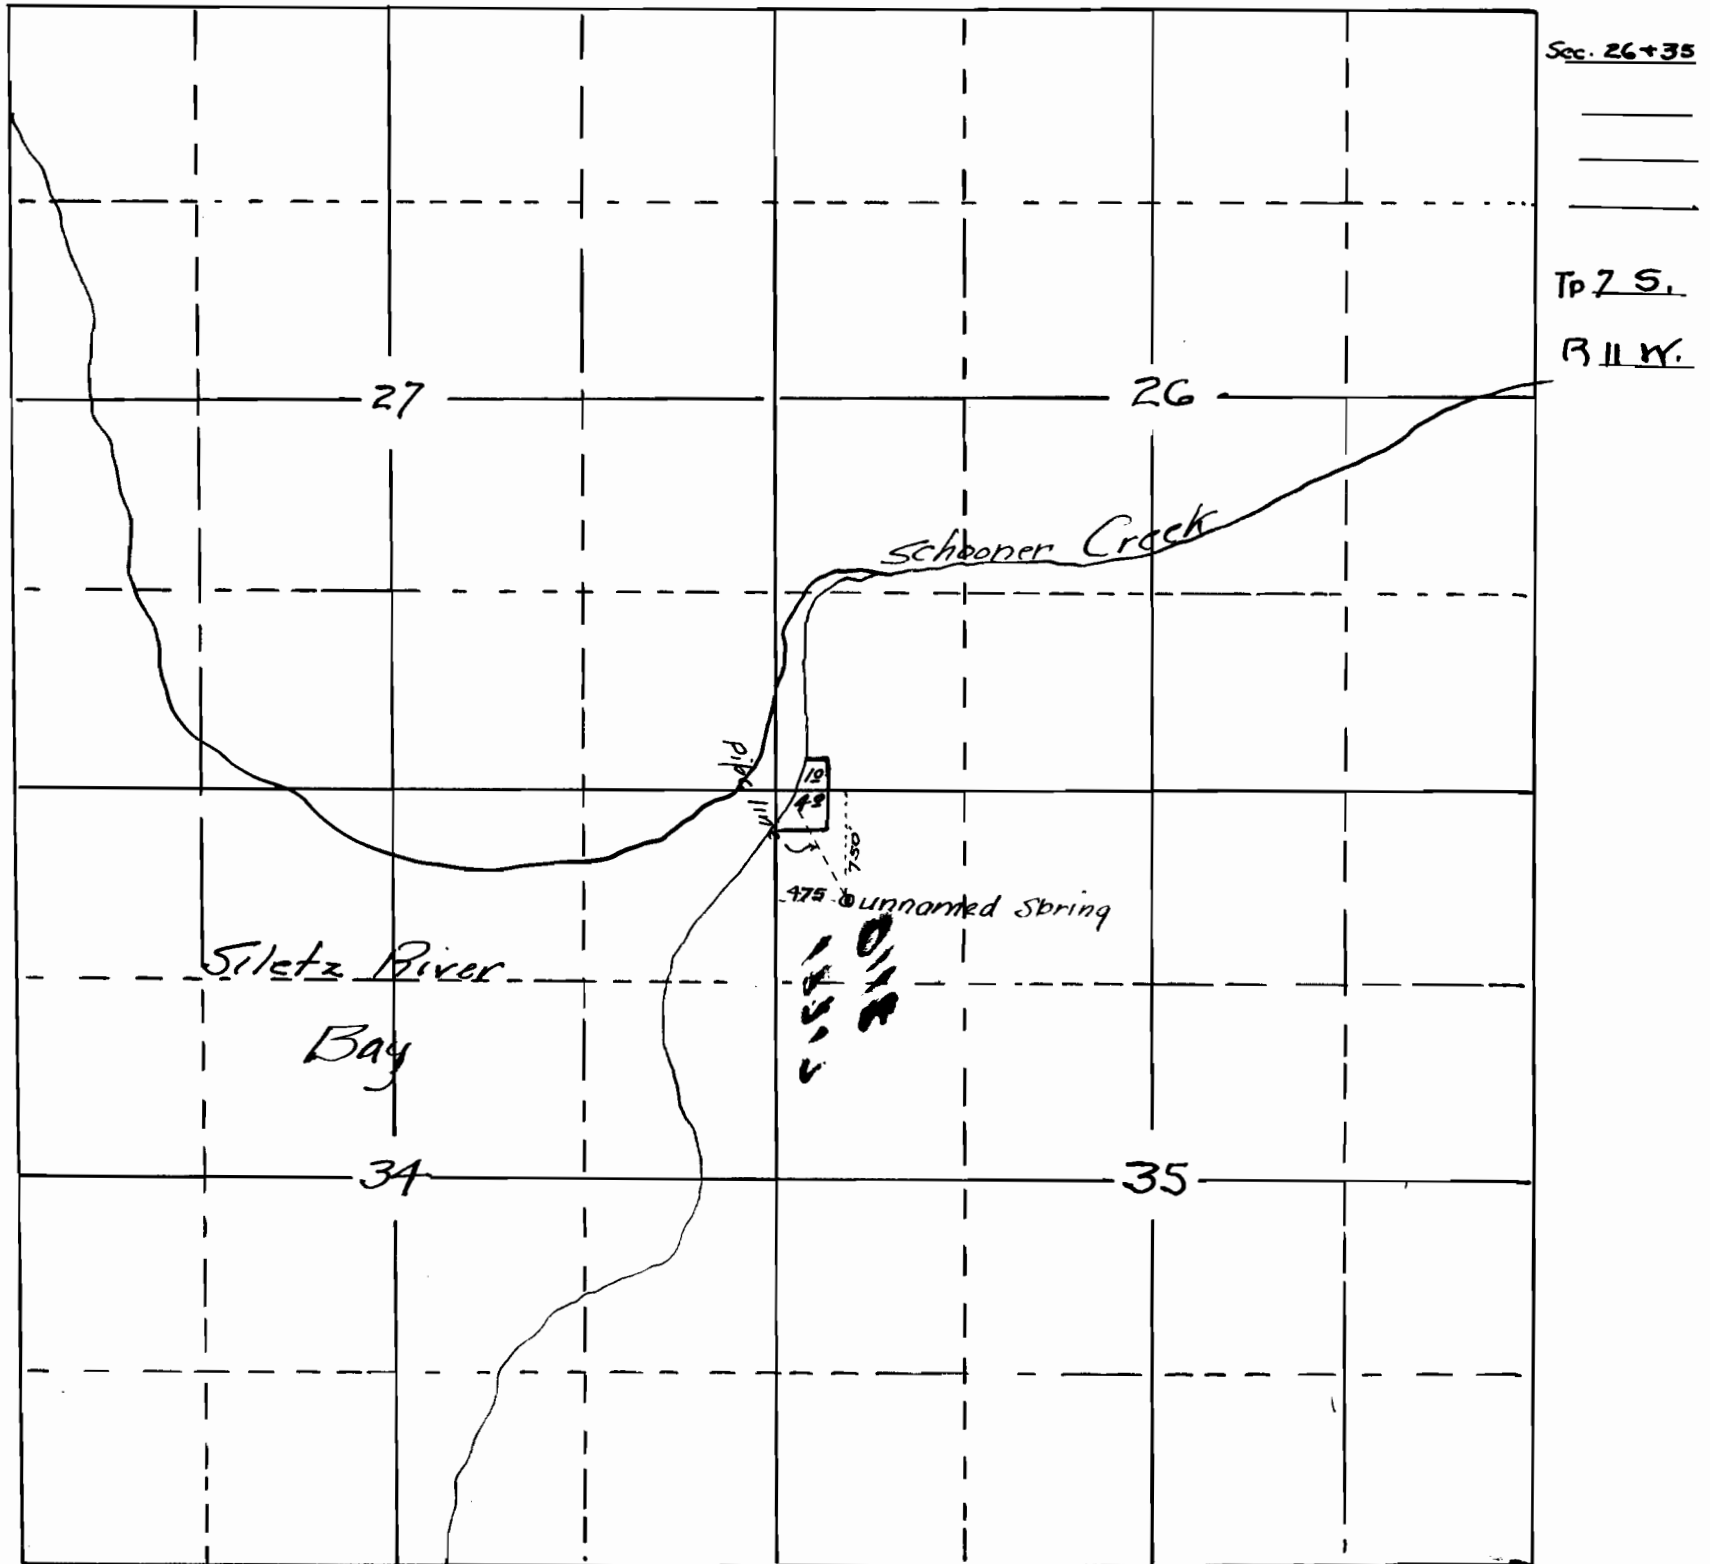

Sec. 26+35

Tp 7 S.

R 11 W.

27

26

Siletz River

Bay

Schooner Creek

unnamed Spring  
975

34

35

18  
750